

MYERS SURVEYING Co.



2740 East Main Street, Columbus 43209 (Bexley), Ohio

SURVEY OF THE EAST HALF & WEST HALF OF LOT 11, SQUIOTO ADDN., OBETZ, OHIO
18385 6825 FOR

DYLARA J. COLE

P.B. 7 Page 498
Scale 1" = 40'

Franklin Co. Rec. Office
2.22.88

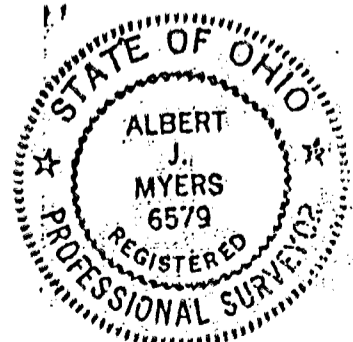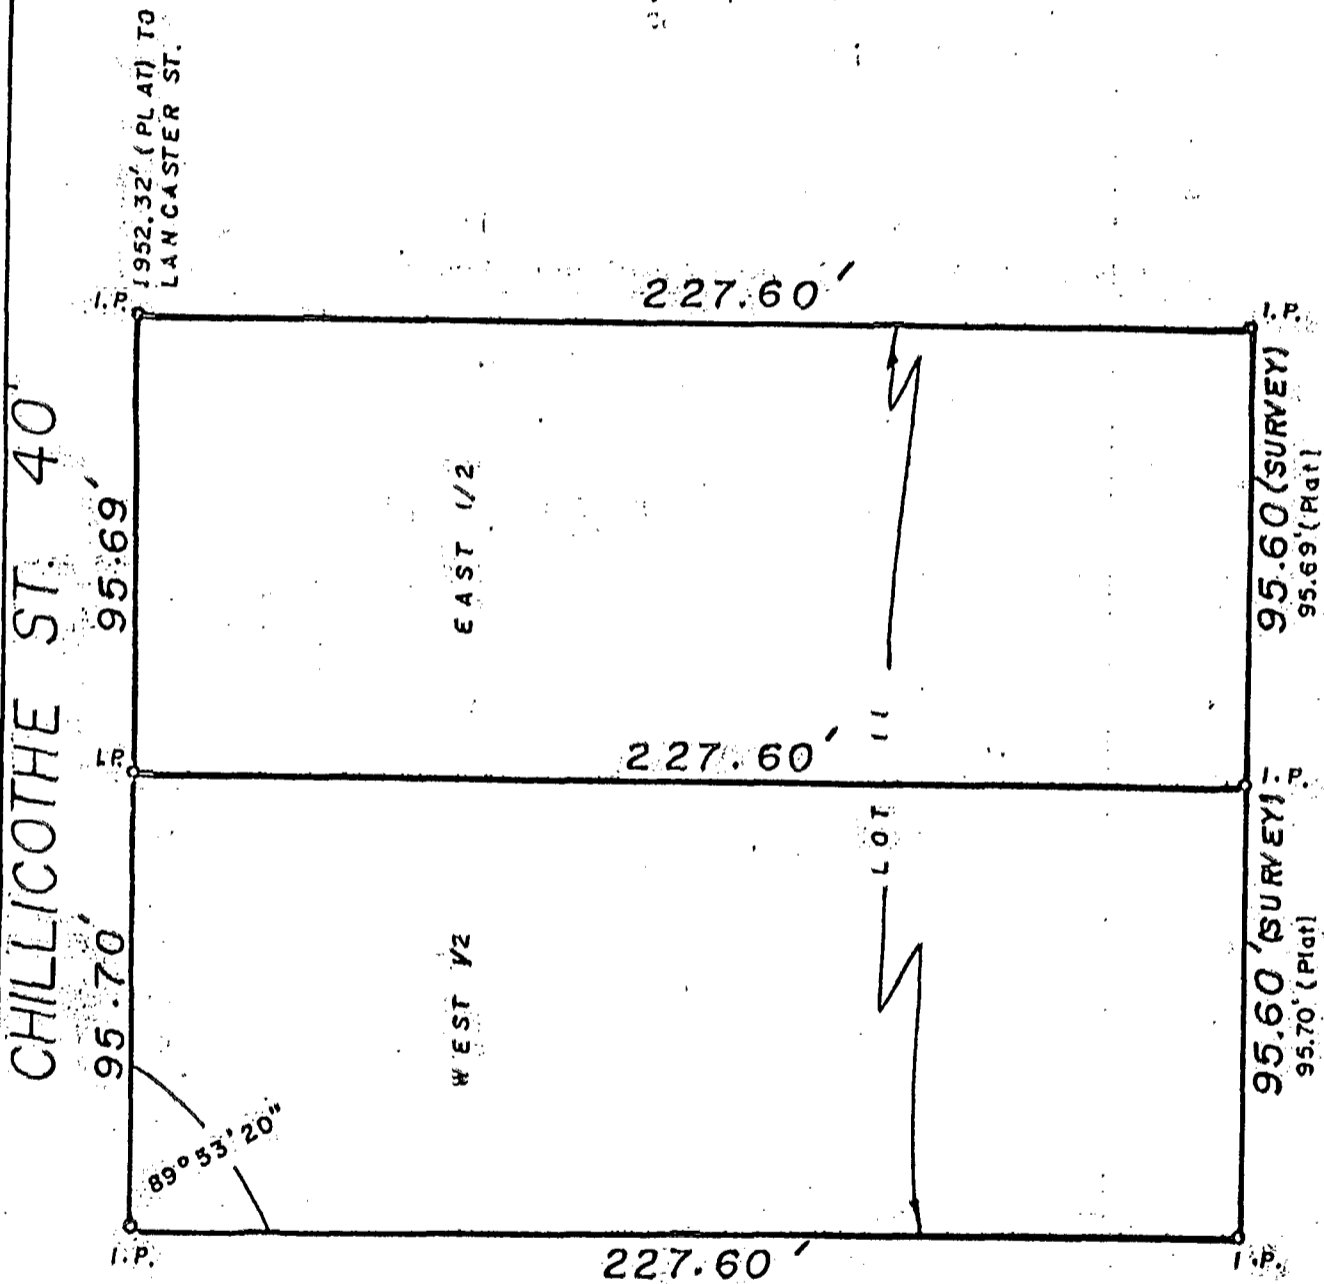

We hereby certify that the foregoing plat was prepared from an actual survey of the premises.

Iron pins not set unless indicated

this -0-

MYERS SURVEYING CO.

BY Albert J. Myers
Registered Surveyor

COLE 11-2-22-88

F D L C