



E Obetz Avenue 50' R/W

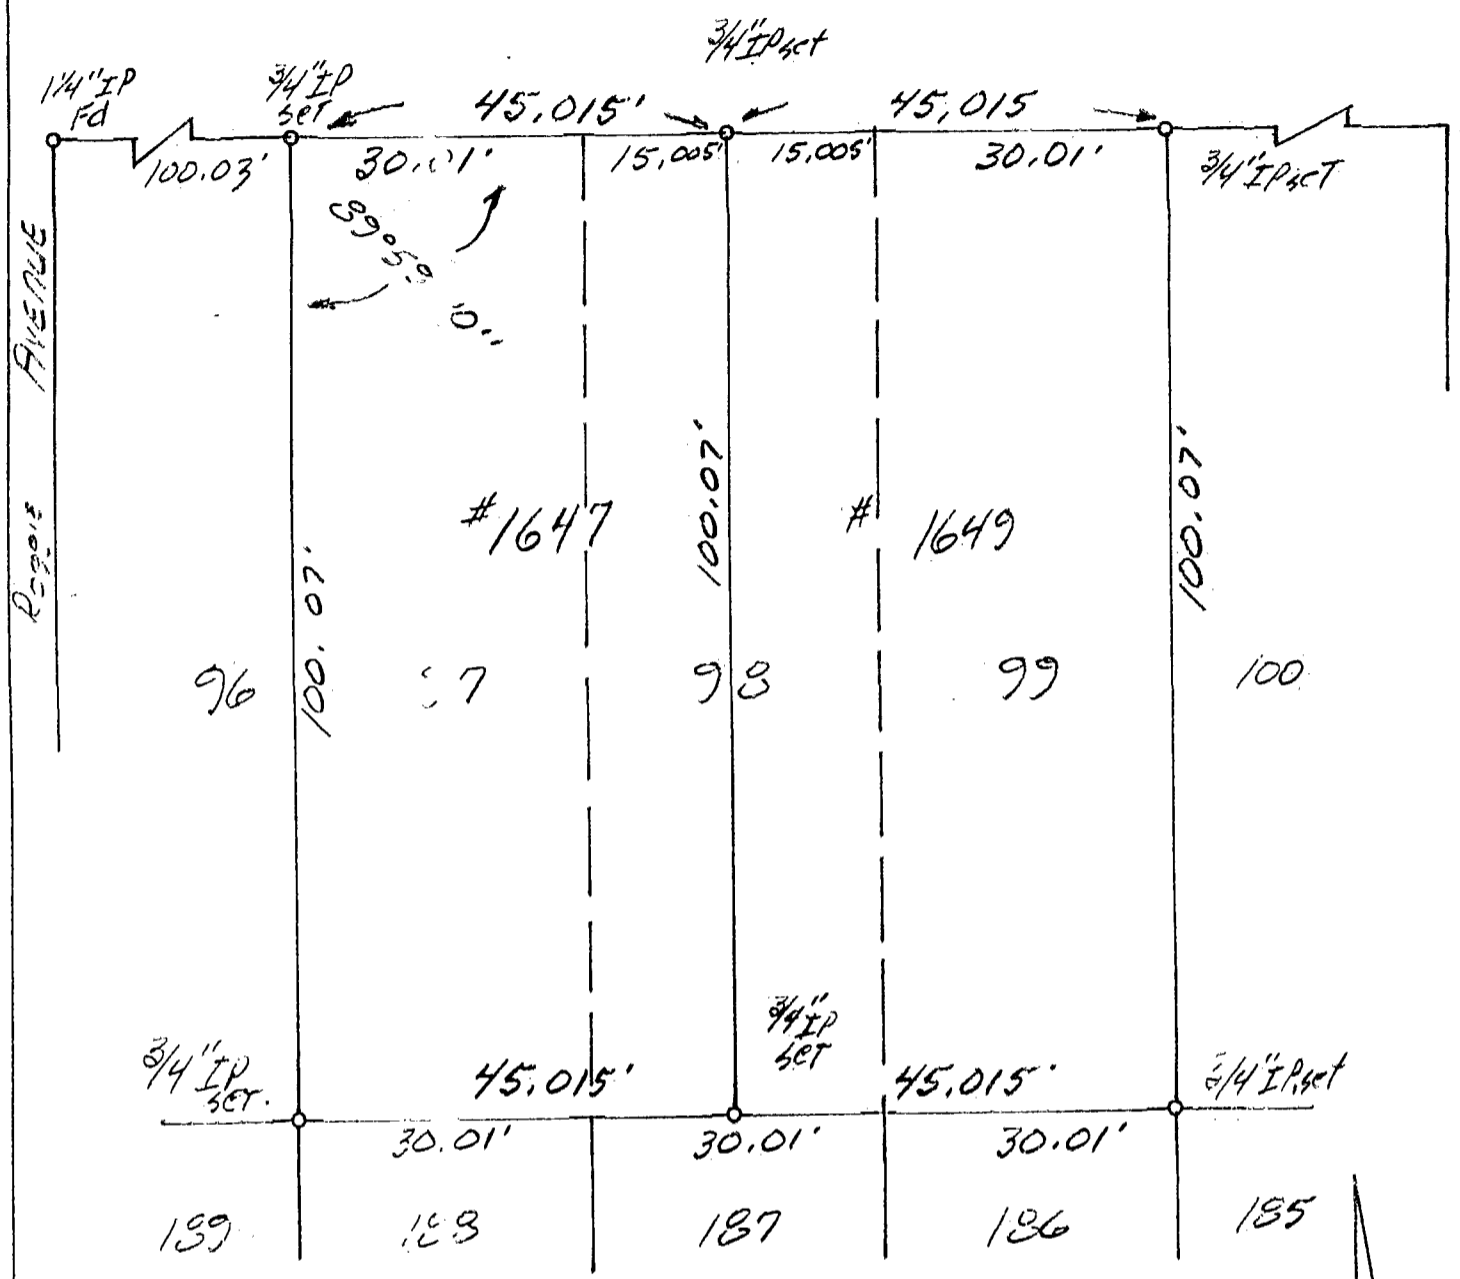

SURVEY OF Lots 97, 98 & 99.
 in the COLUMBUS TERRACE Add'n
 P.B. 9 P. 4, Village of Obetz,
 Franklin Co., Ohio; FOR

the Estate of Betty Ankrom

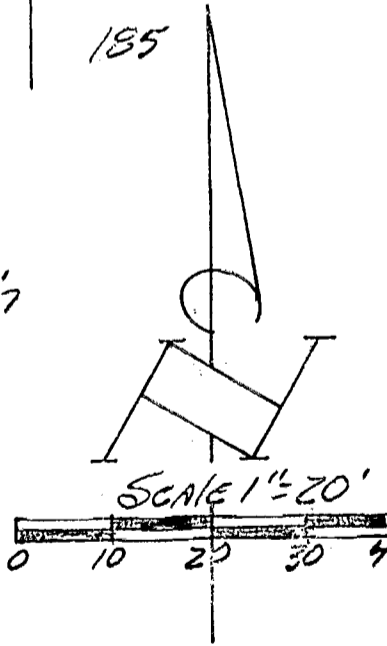

HAINES SURVEYORS
 354 Kester Street
 Groveport, Ohio 43125
 Phone: 837-2181



I hereby certify that the plat shown hereon was performed from an actual field survey, under my supervision and that said plat correctly represents said survey.
 DATE 12-9-95 SIGNED Louis J. Haines

HAMILTON 183 356 825