Pomeroy & Associates Inc.
Consulting Engineers & Surveyors
599 Scherers Court • Worthington, Ohio 43085
Phone(614)885-2498 • Fax(614)885-2886

CSX PROPERTY SPLIT

SECT. 26, TWP. 4N, RANGE 22W
CONGRESS LANDS

FRANKLIN COUNTY, OHIO

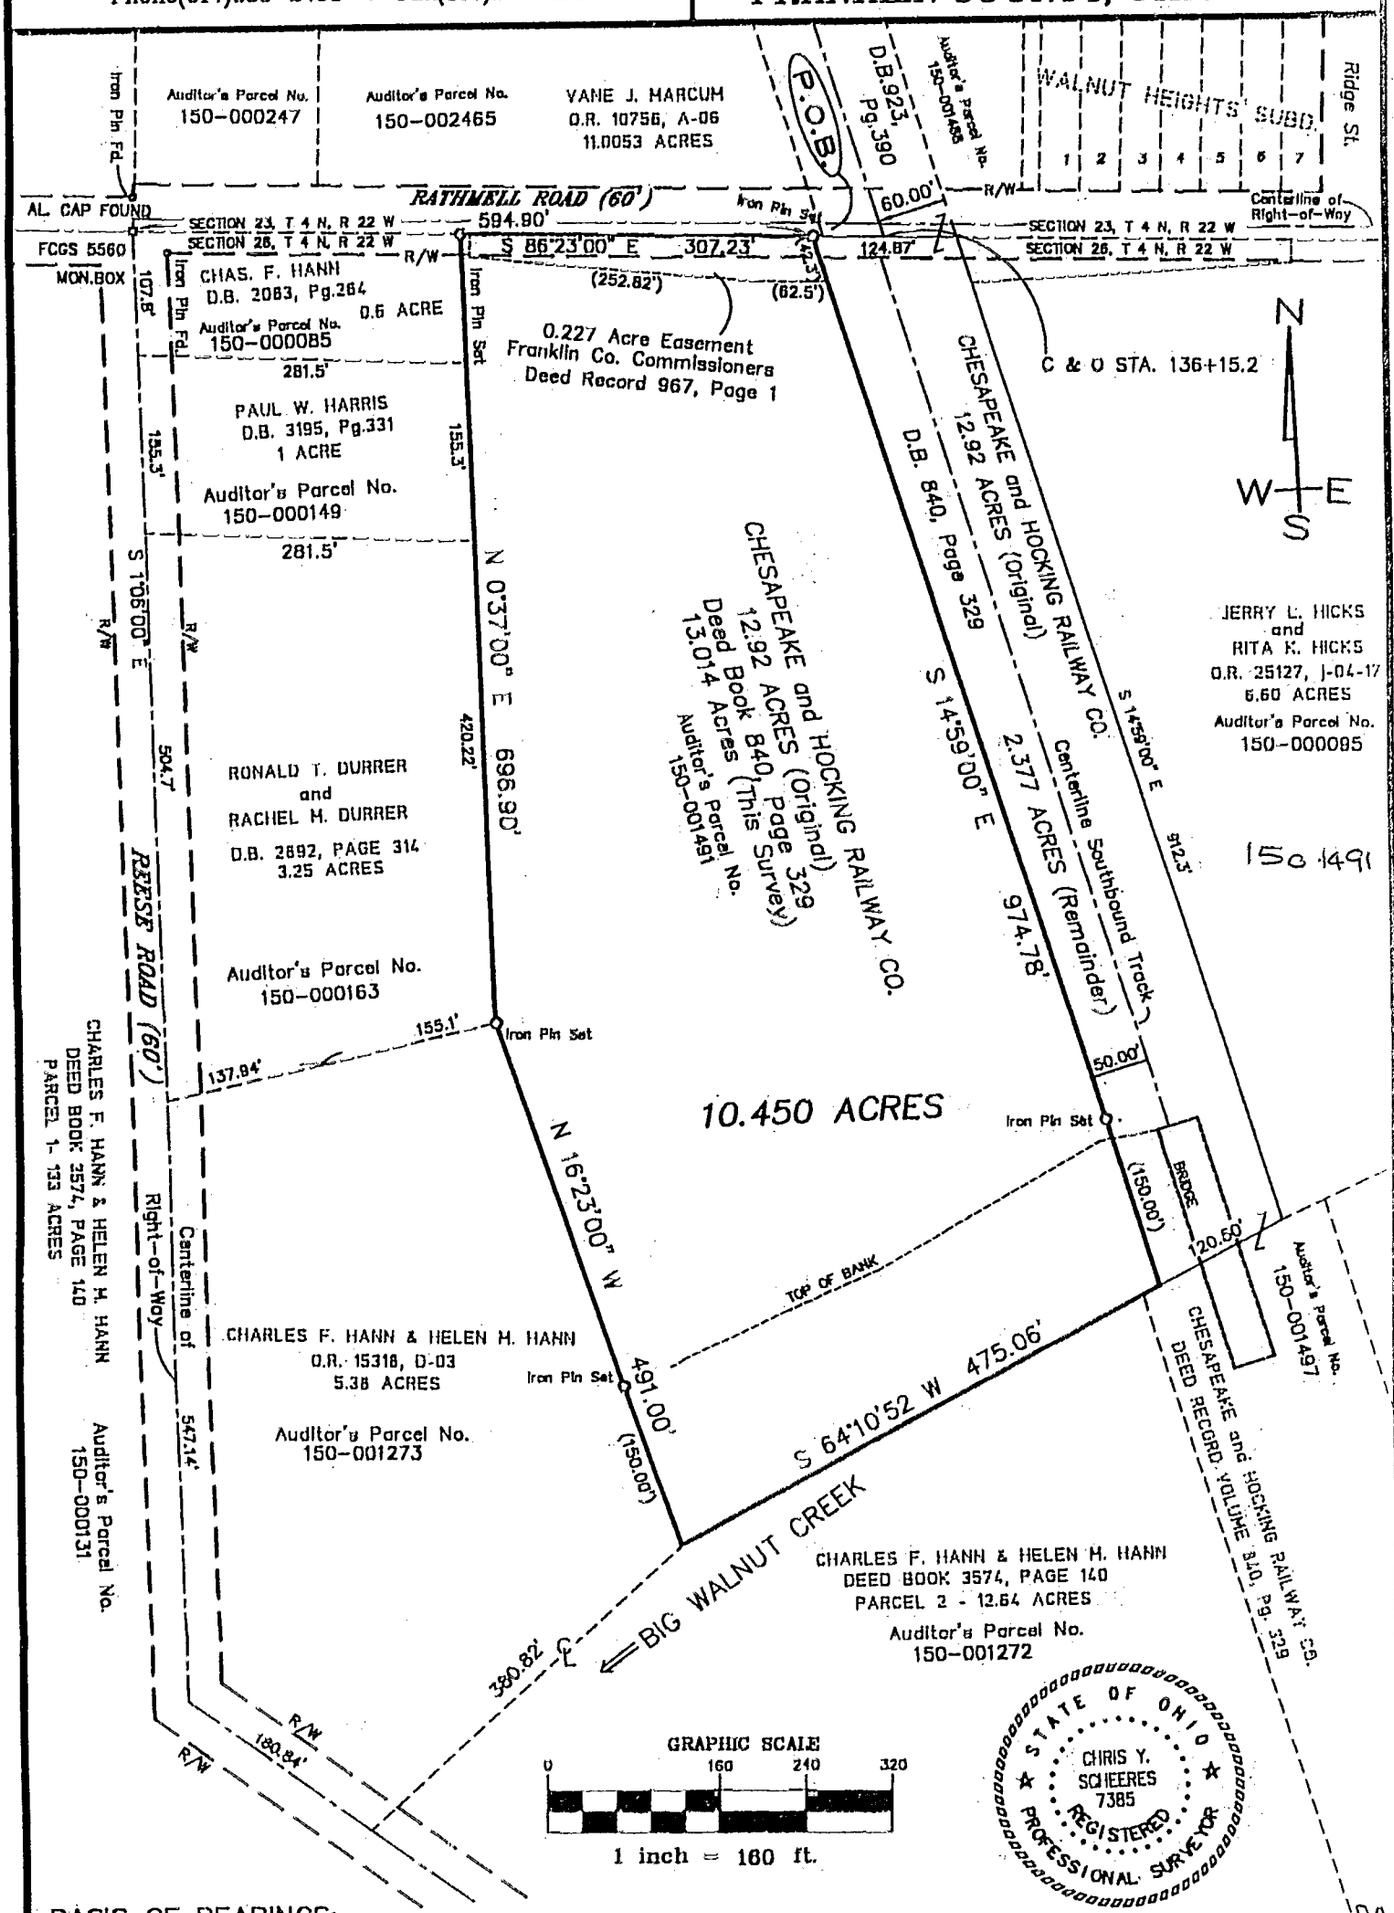

BASIS OF BEARINGS:
Same Meridian as the centerline of Rathmell Road, being S 86° 23' E, as shown and delineated on the roadway plan sheet 11 of 30 (dated 1935) for Rathmell Road (No. 121) of record at the Fanklin Co. Engineers Office.

DRAWN	CHECKED
DFB	JMR

BY: 16 May 1997

HAMILTON 83-856.750
83-856.775