
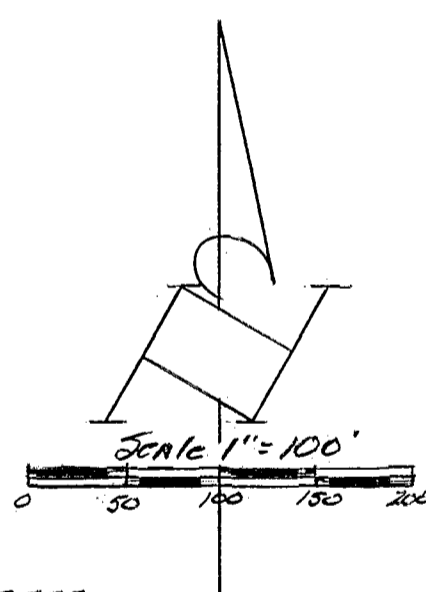


B 2606-250

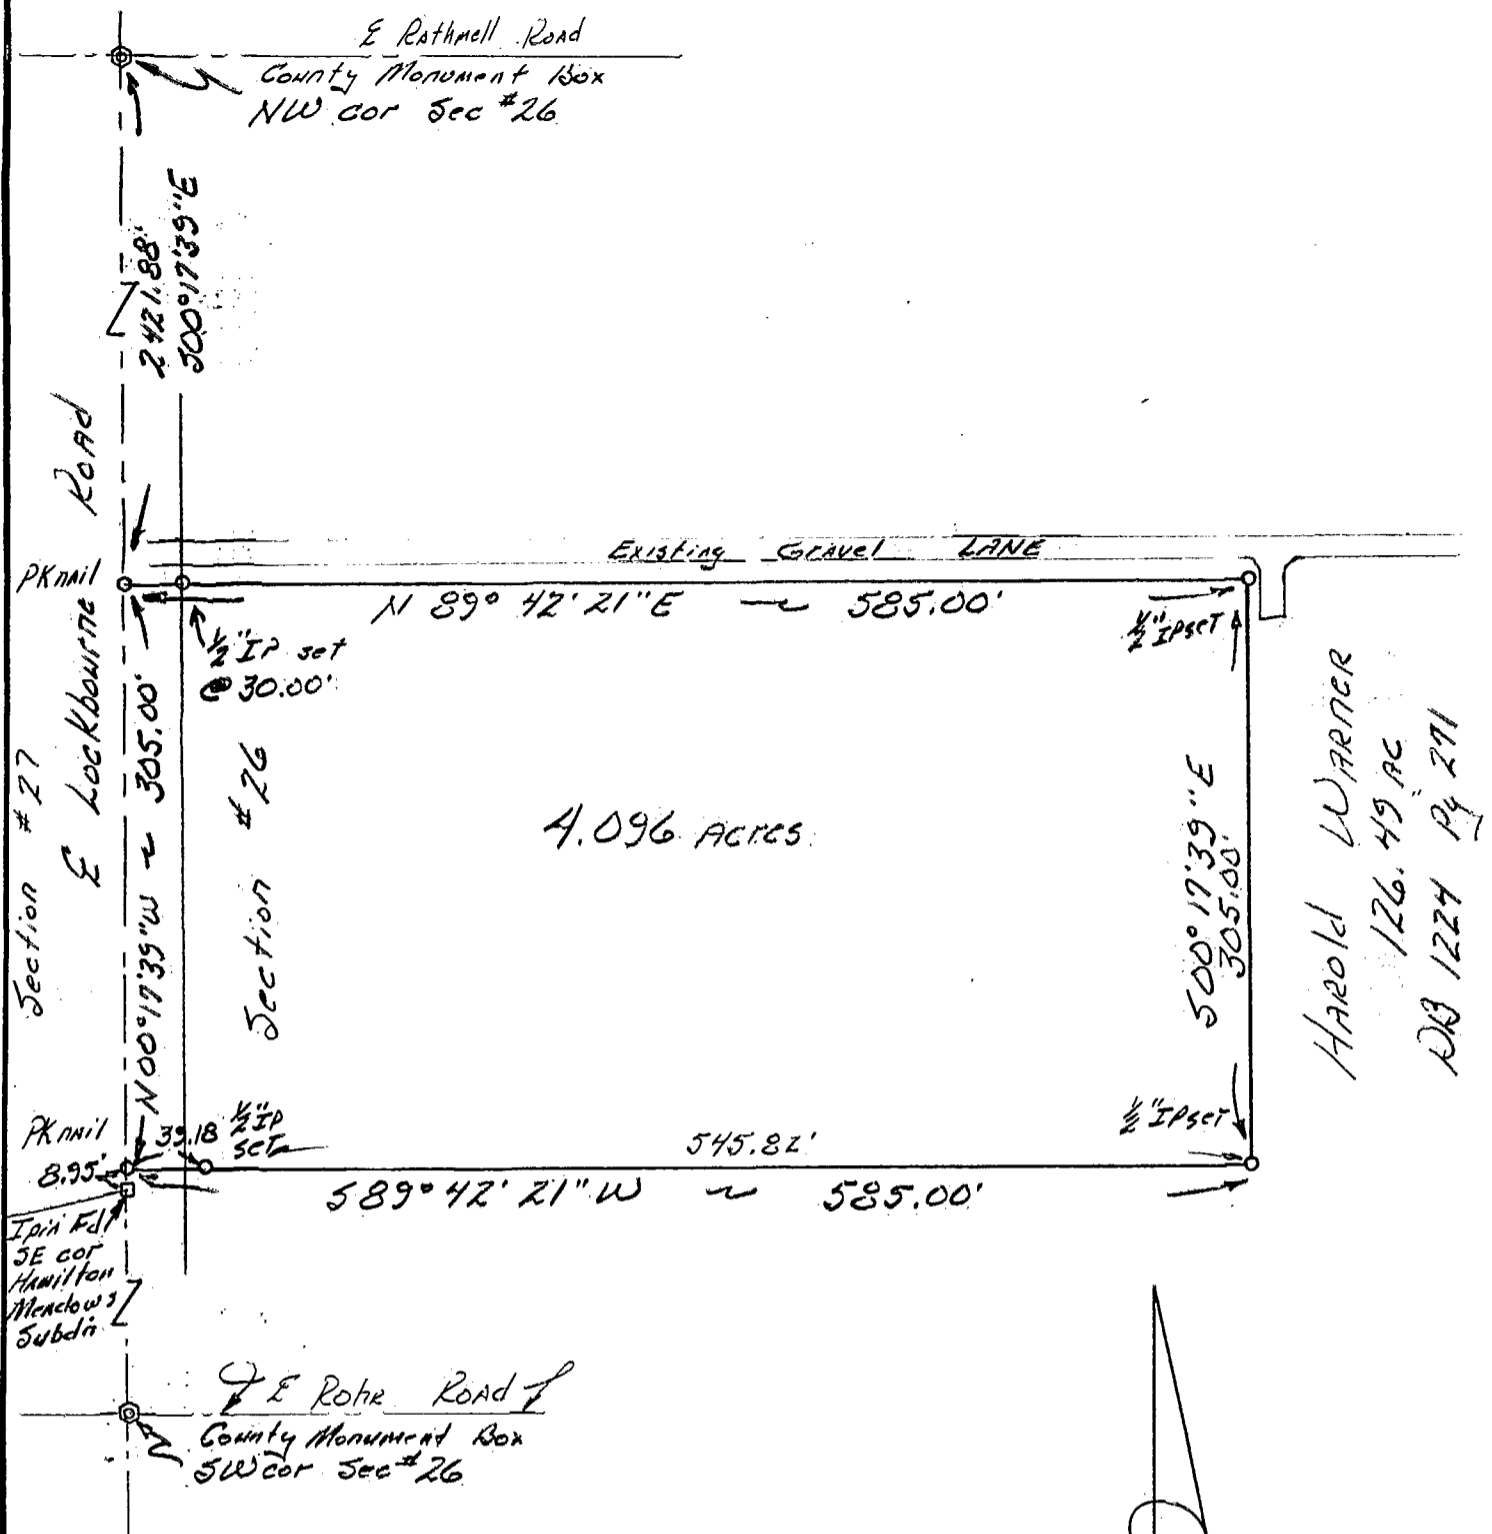

SURVEY OF 4.096 ACRES
in the West 1/2 Sec #26, Hamilton Twp.
Franklin Co., Ohio : For

Phil Wilburn

"Bearings used for this survey
are assumed and relative only
to this survey."



LOUIS F. HAINES
SURVEYOR
354 KESSLER ST.
GROVEPORT, OH. 43125

Phone 837-2181

I hereby certify that the plat shown hereon was prepared from
an actual field survey, under my supervision and that said plat
correctly represents said survey.

DATE: Aug 23, 1987 SIGNED: Louis F. Haines

0-26-A
HAMILTON Twp