

DPH SURVEYING, INC.

CONSULTING ENGINEERS AND SURVEYORS
P.O. BOX 429 THORNVILLE, OHIO 43076

OHIO PHONE: 1-800-648-8151 FAX NO. 1-800-648-8150


PROPERTY LOCATION

SITUATED IN THE STATE OF OHIO, COUNTY OF FRANKLIN,
VILLAGE OF OBETZ, SOUTHWEST QUARTER OF SECTION
24, TWP.-4, RNG.-22, MATHEW'S SURVEY, CONGRESS LANDS.
BEING THE PARCEL DESCRIBED IN OR. 29680 PAGE C-17.

PREPARED FOR:

FREDRICK W. WATKINS
2655 RATHMILL ROAD
COLUMBUS, OHIO 43207
c/o AMERITITLE EAST
F/W 9-14-95 LM/GH
INVOICE NO. 95-08293
FILE NO. 95-1106Fr

O-24-D

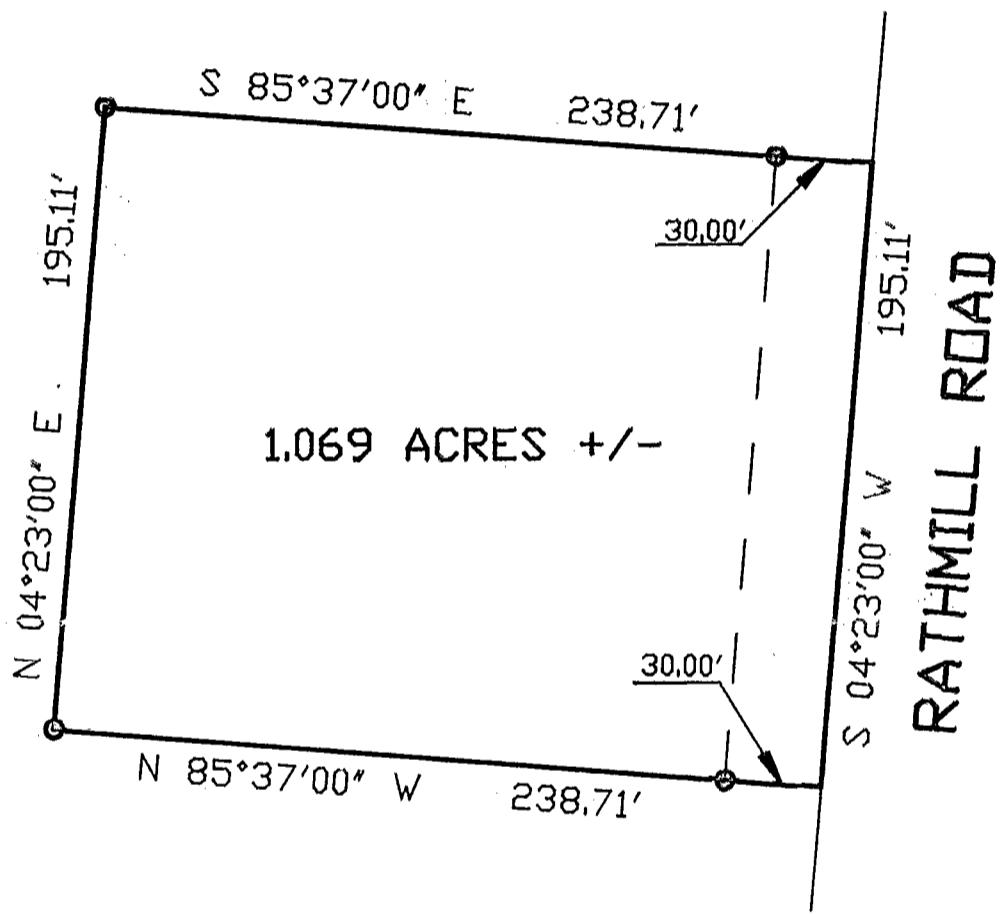


NOTE: ALL PINS SET ARE 5/8" o.d. IRON REINFORCEING BARS WITH YELLOW CAPS LABELED "DENNIS P. HAGAN #6917".

LEGEND

- - IRON PIN FOUND
- ⊙ - IRON PIN SET
- △ - RAILROAD SPIKE FOUND
- ▲ - RAILROAD SPIKE SET
- ☆ - P. K. NAIL FOUND
- ★ - P. K. NAIL SET

BEARINGS OF THIS PLAT ARE BASED ON THE CENTERLINE OF RATHMILL ROAD AS BEING:
S 04°23'00" W

I HEREBY CERTIFY THAT AN ACTUAL SURVEY WAS MADE OF THE PREMISES AND THAT THIS PLAT IS CORRECT TO THE BEST OF MY KNOWLEDGE.

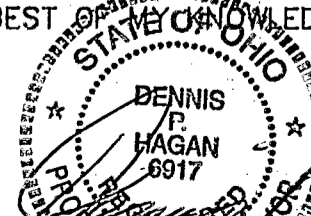

DATED 9/8/95

DENNIS P. HAGAN, P.S.
OHIO REGISTERED SURVEYOR #6917

HAM-700
84356775
O-24-D