



80106725

Situated in the State of Ohio, County of Franklin, City of Grove City, and Township of Jackson, being part of Virginia Military Survey No. 1434 and being 0.262 acres out of an original 10.385 acres and being 0.175 acres out of the Township of Jackson, and being 0.087 acres out of the City of Grove City.

Concrete Construction Company, Inc.
Deed Book 3133 Page 08
29.793 Acres

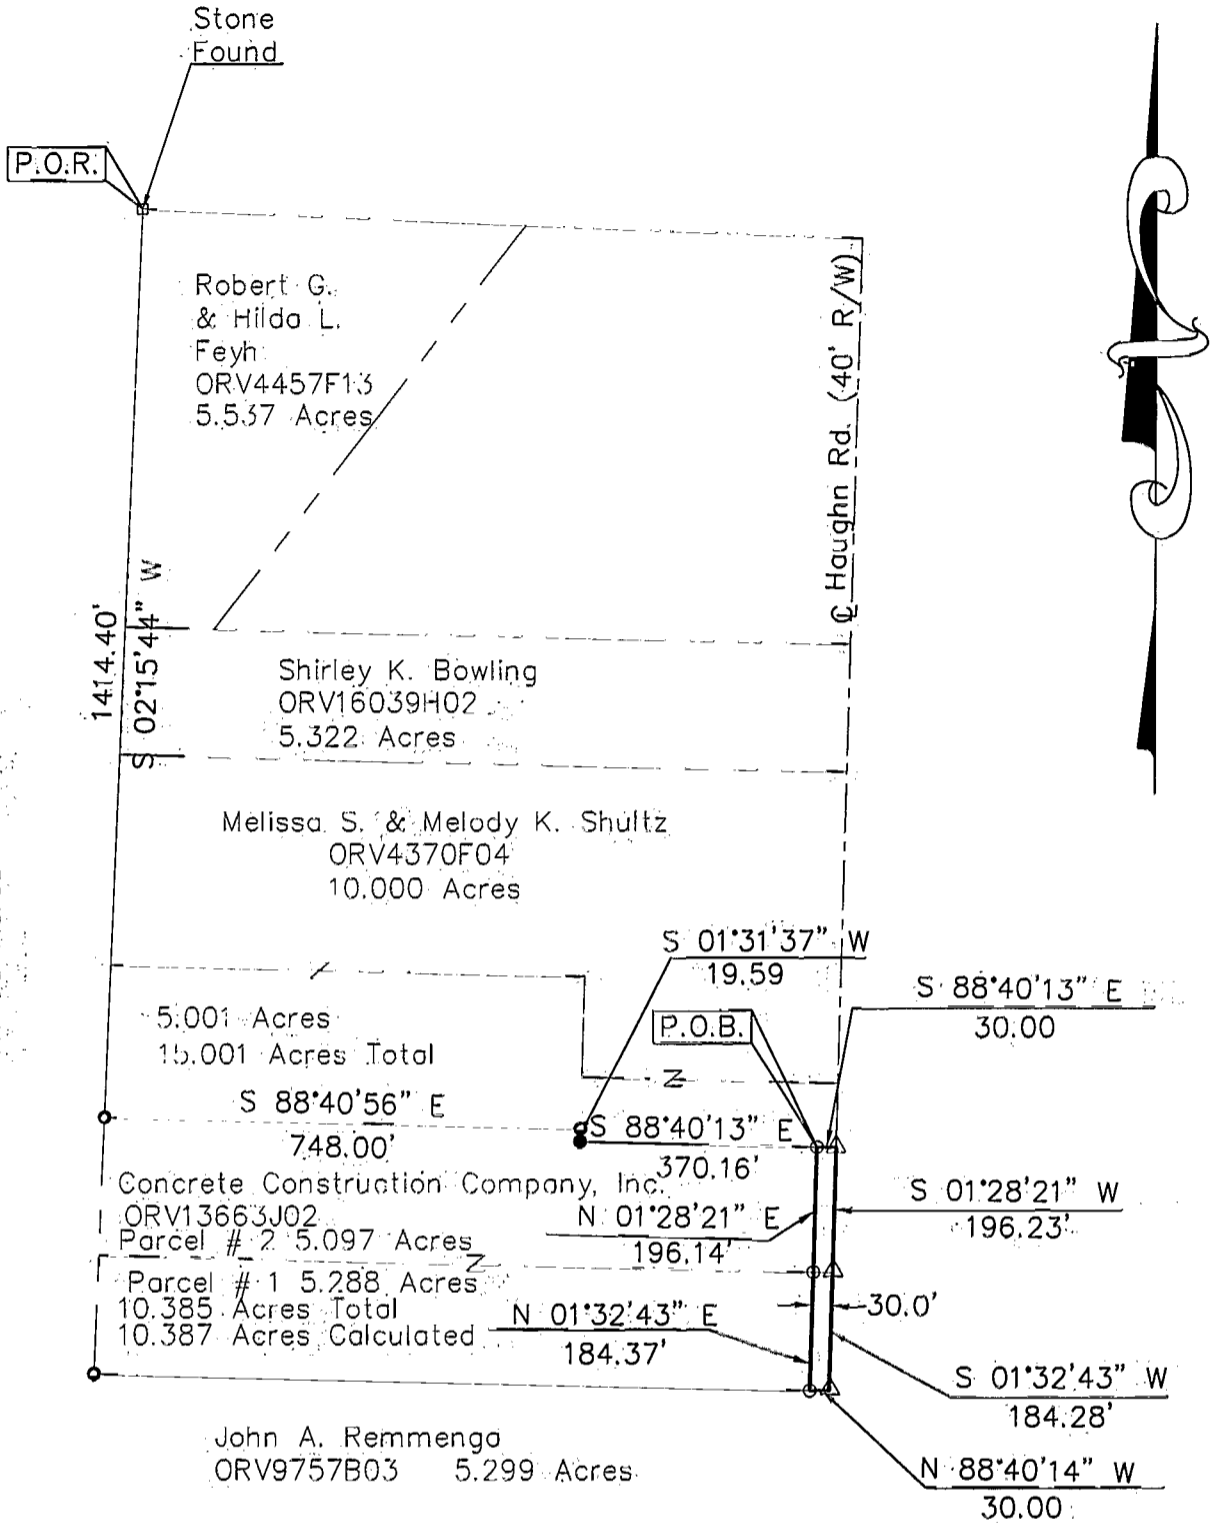

- ▲ = R.R. Spk. Fnd.
 - △ = R.R. Spk. Set
 - = I.P. Fnd.
 - = I.P. Set
- I.P. Set are 3/4" I.D.
Iron Pin 30" long with cap inscribed EDG.

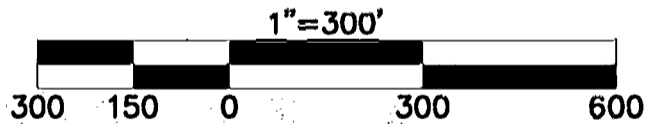

This plat was prepared by Environmental Design Group Inc., Columbus, Ohio from an actual field survey April 1998. The bearing basis S 01°28'21" W for the centerline of Haughn Road.

Maynard H. Thompson 8/23/00
 Maynard H. Thompson, P.S. No. 7128 Date
 Environmental Design Group

PROJ. NO:	RUSCILLI
FILE NO:	0_26RW.dwg
DRAWN BY:	MHT
CHKD. BY:	MHT



ENGINEERS - LANDSCAPE ARCHITECTS - SURVEYORS
 9015 Antares Avenue Tel. 614 433 9015
 Columbus, OH 43240 Fax. 614 433 9513

0.262 Acres
 RIGHT OF WAY
 HAUGHN ROAD

JACKSON
 TRAP
 O-33-H