



Situated in the State of Ohio, County of Franklin, City of Grove City, and Township of Jackson, being part of Virginia Military Survey No. 1434 and being 0.262 acres out of a 131.091 acres tract and being 0.175 acres out of the Township of Jackson, and being 0.087 acres out of the City of Grove City.

80106725

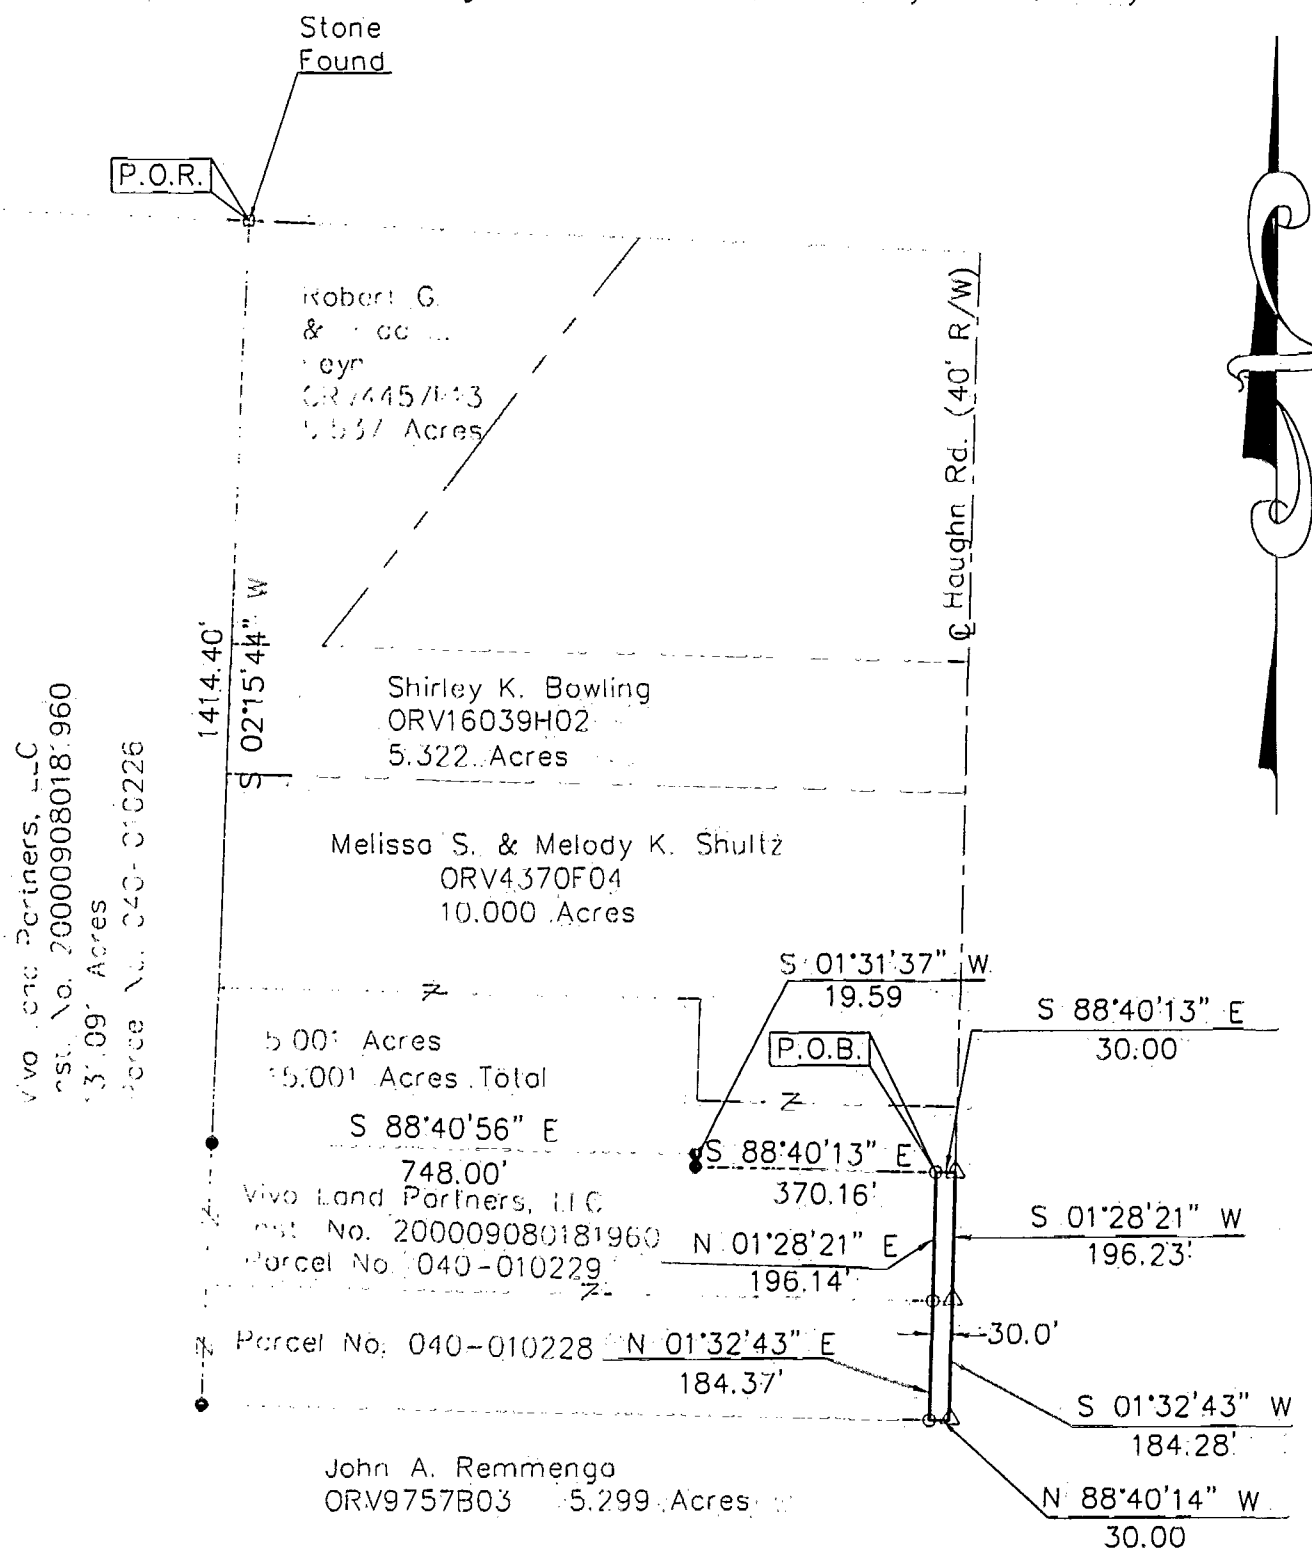

Vivo Land Partners, LLC
Inst. No. 200009080181960
Parcel No. 040-010226

▲ = R.R. Spk. Fnd.
 △ = R.R. Spk. Set
 ● = I.P. Fnd.
 ○ = I.P. Set
 I.P. Set are 3/4" I.D.
 Iron Pin 30" long with
 cap inscribed EDG.

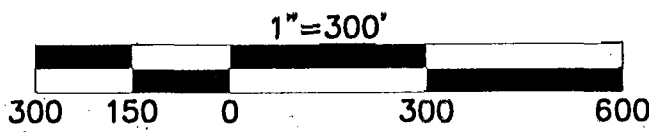

This plat was prepared by Environmental Design Group Inc., Columbus, Ohio from an actual field survey April 1998. The bearing basis S 01°28'21" W for the centerline of Haughn Road.

Maynard H. Thompson
 Maynard H. Thompson, P.S. No. 7128
 Environmental Design Group
 Date: 9/19/00

PROJ. NO: RUSCILL
 FILE NO: 0_26RW.dwg
 DRAWN BY: MHT
 CHECKED BY: MHT



0.262 Acres
 RIGHT OF WAY
 HAUGHN ROAD

JACKSON Twp.
 0-33-4

80106725 split (040) 10228+ (049) 10229