

81 106 700
81 106 625

BOUNDARY SURVEY OF 5.047 ACRES OUT 23.353 ACRE TRACT
STATE OF OHIO
COUNTY OF FRANKLIN
TOWNSHIP OF JACKSON
VIRGINIA MILITARY SURVEY NO. 6115


(SCALE IN FEET)
1 inch = 200 ft.

- LEGEND:**
- = FOUND IRON PIN
 - △ = FOUND RIALROAD SPIKE
 - ▲ = SET RAILROAD SPIKE
 - = SET IRON PIN
 - Ⓜ = FOUND FRANKLIN COUNTY MONUMENT

- NOTES:**
- 1.) BEARING SHOWN HEREON AS BASED ON THE CENTERLINE OF BORROR ROAD AS DELINATED ON FRANKLIN COUNTY HIGHWAY PLANS NO. 0350-010, DATED 1949, BEING N00°11'00"W.
 - 2.) ALL OF THE EXCEPTIONS REFERENCED IN OFFICIAL RECORD 6925-A17 DID NOT MEET MATHIMATICAL CLOSURE.
 - 3.) ALL REFERENCES TO SET IRON PINS ARE 5/8"DIA., 30" IN LENGHT AND CAPPED D.LUCAS P.L.S. 7866.



David M. Lucas 6-24-98
DAVID M. LUCAS DATE
PROFESSIONAL SURVEYOR
7866

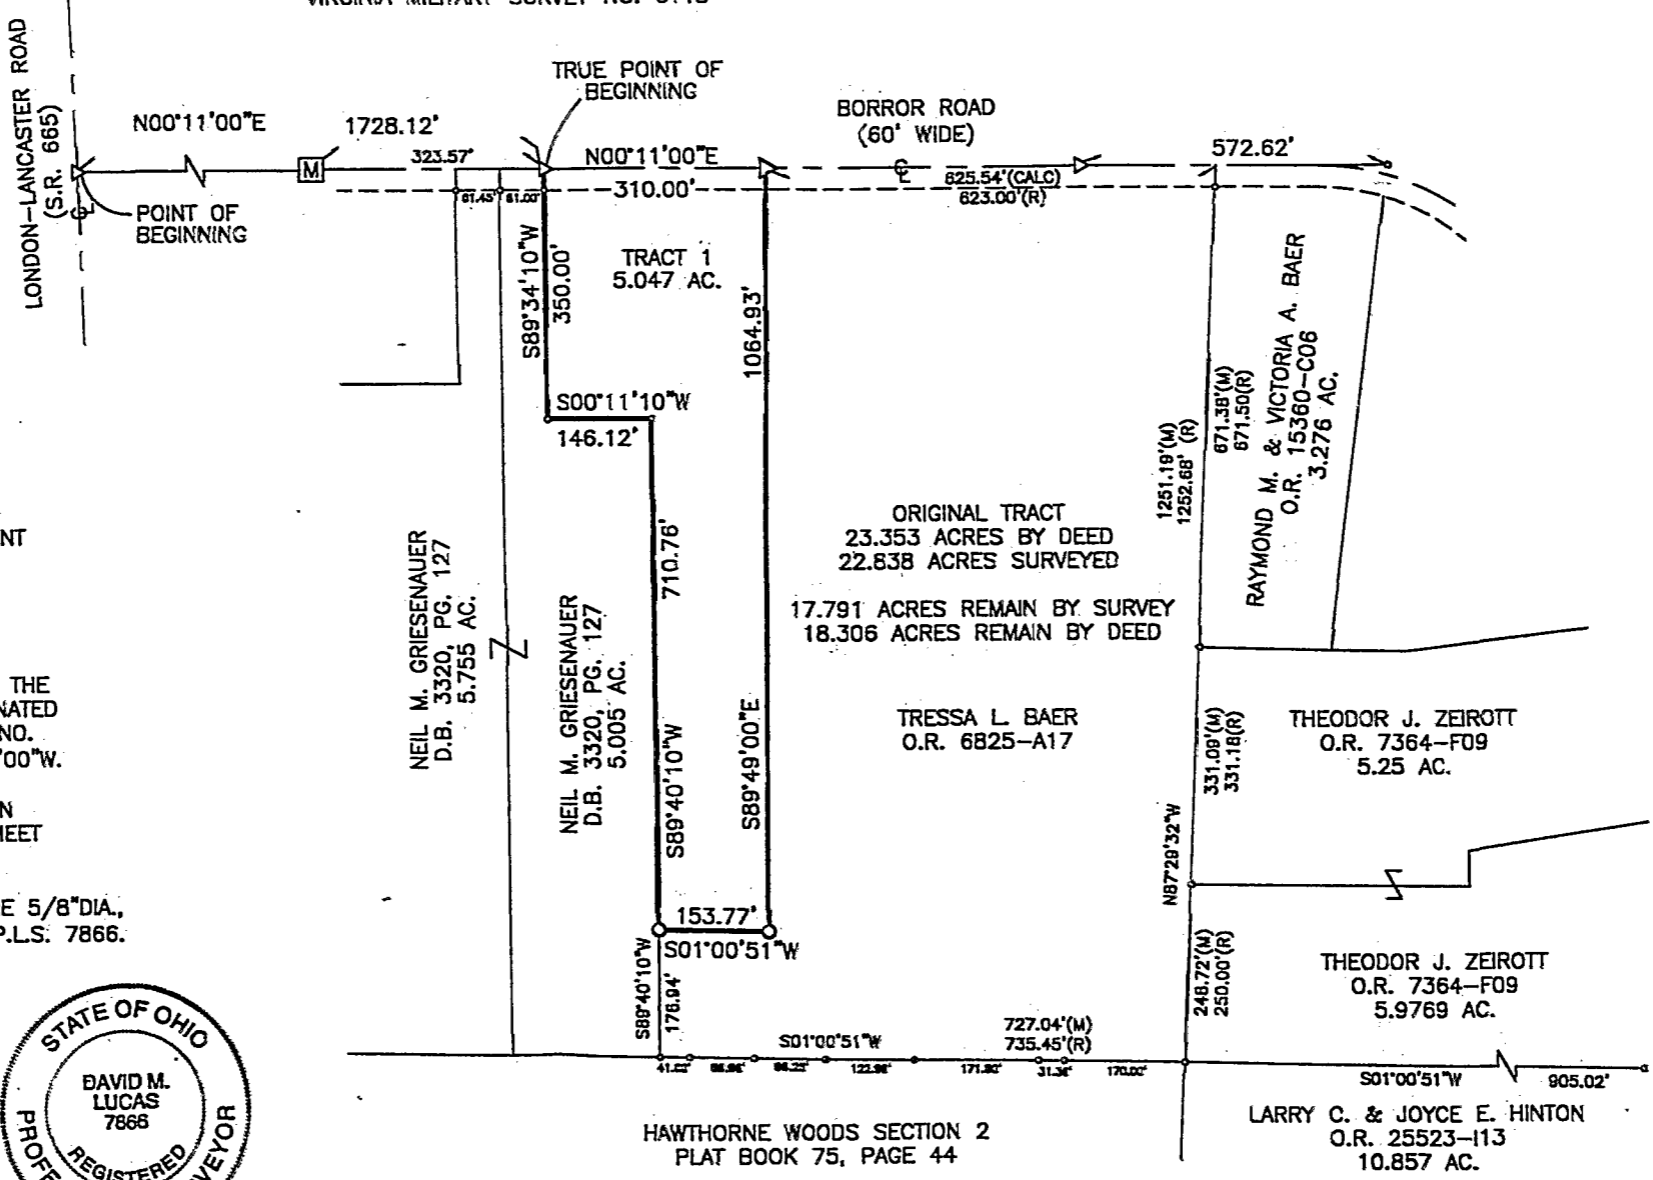

CERTIFICATION: WE HEREBY CERTIFY THAT THE FOREGOING BOUNDARY SURVEY WAS PREPARED FROM A ACTUAL FIELD MEASURMENTS IN ACCORDANCE WITH CHAPTER 4733 - 37, OHIO ADMINISTRATIVE CODE, AND MEETS MINIMUM STANDARDS FOR BOUNDARY SURVEYS IN THE STATE OF OHIO.

Prepared By: Lucas Land Surveying, LTD
5073 Sanderson Drive
Columbus, Ohio 43228
Office: (614)851-1170
Fax: (614)851-8807

JOB NO. 98-130