

81 106 700
81 106 675

BOUNDARY SURVEY OF REMAINING 17.791 ACRES OUT OF ORIGINAL 50.00 ACRE TRACT
STATE OF OHIO
COUNTY OF FRANKLIN
TOWNSHIP OF JACKSON
VIRGINIA MILITARY SURVEY NO. 6115



(SCALE IN FEET)
1 inch = 200 ft.

LEGEND:

- = FOUND IRON PIN
- △ = FOUND RAILROAD SPIKE
- △ = SET RAILROAD SPIKE
- = SET IRON PIN
- Ⓜ = FOUND FRANKLIN COUNTY MONUMENT

NOTES:

- 1.) BEARING SHOWN HEREON AS BASED ON THE CENTERLINE OF BORROR ROAD AS DELINEATED ON FRANKLIN COUNTY HIGHWAY PLANS NO. 0350-010, DATED 1949, BEING N00°11'00"W.
- 2.) ALL OF THE EXCEPTIONS REFERENCED IN OFFICIAL RECORD 6925-A17 DID NOT MEET MATHEMATICAL CLOSURE.
- 3.) ALL REFERENCES TO SET IRON PINS ARE 5/8"DIA., 30" IN LENGTH AND CAPPED D.LUCAS P.L.S. 7866.

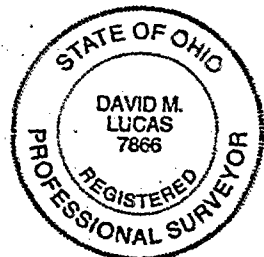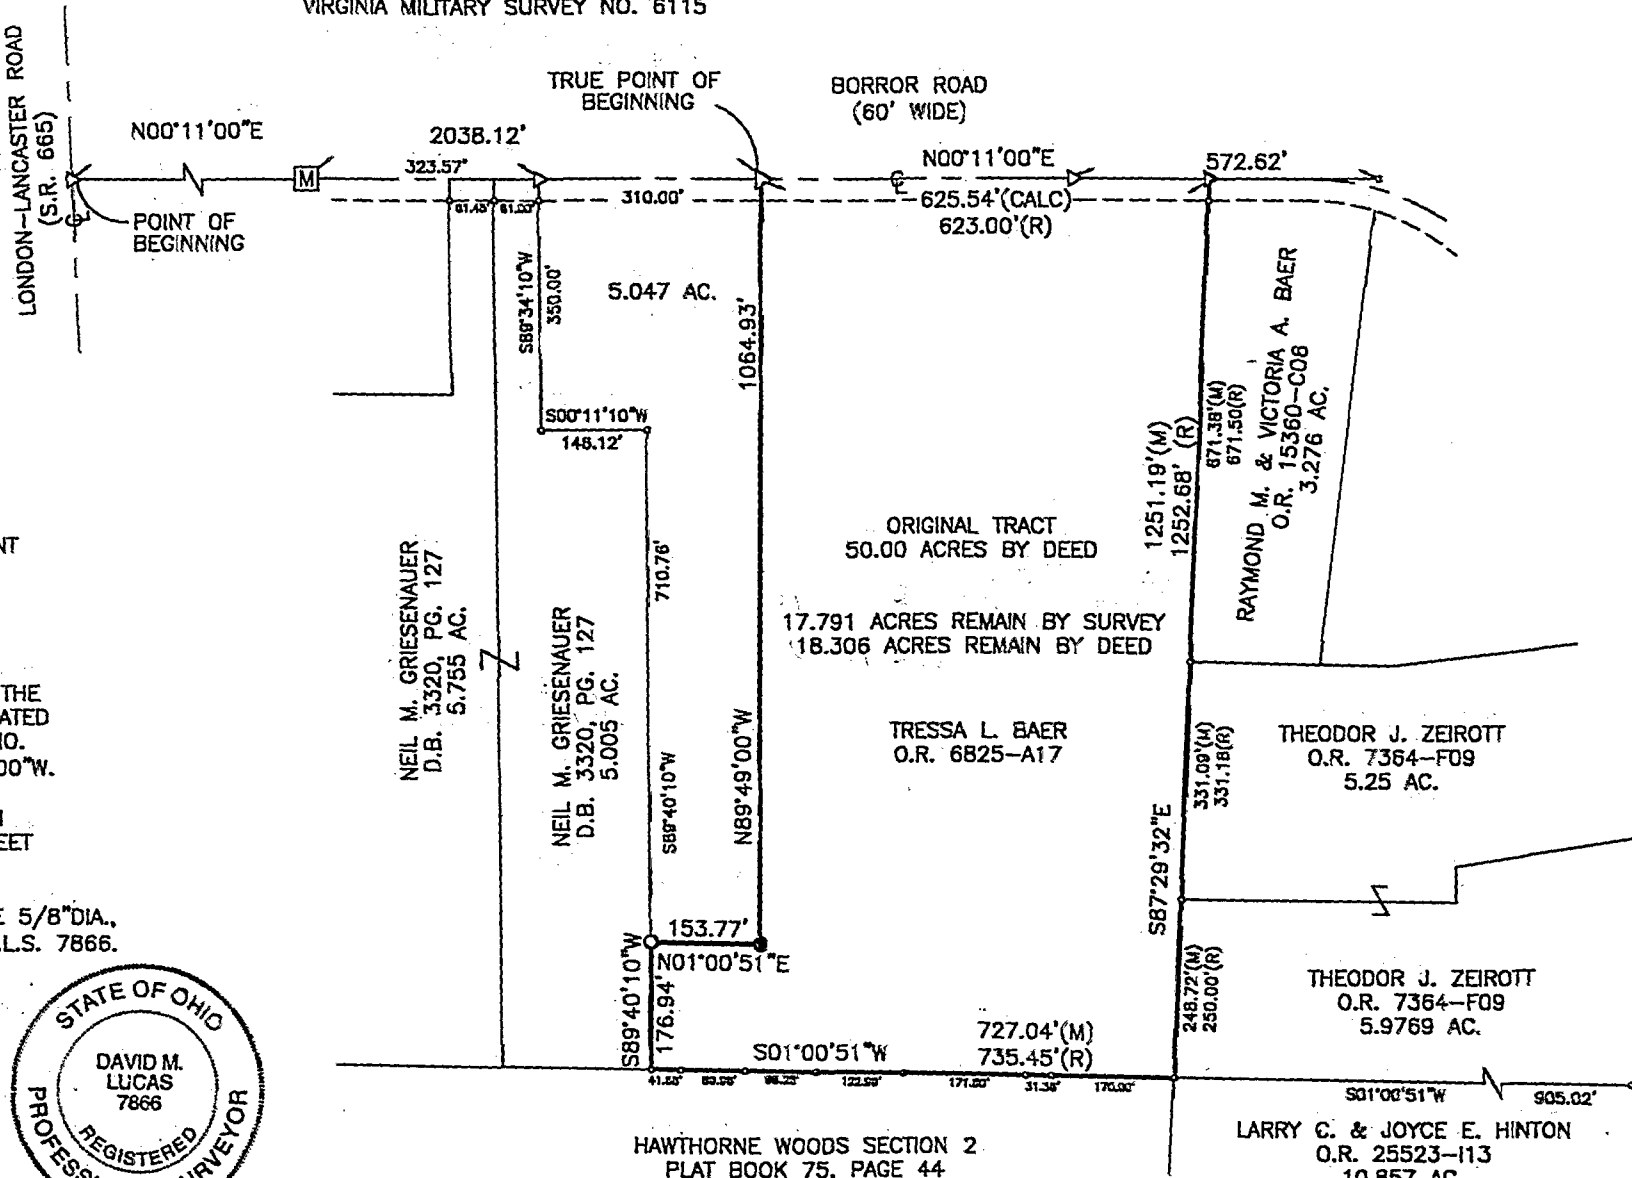

David M. Lucas 6-24-98
DAVID M. LUCAS DATE
PROFESSIONAL SURVEYOR

CERTIFICATION: WE HEREBY CERTIFY THAT THE FOREGOING BOUNDARY SURVEY WAS PREPARED FROM A ACTUAL FIELD MEASUREMENTS IN ACCORDANCE WITH CHAPTER 4733 - 37, OHIO ADMINISTRATIVE CODE, AND MEETS MINIMUM STANDARDS FOR BOUNDARY SURVEYS IN THE STATE OF OHIO.

Prepared By: Lucas Land Surveying, LTD
5073 Sanderson Drive
Columbus, Ohio 43228
Office: (614) 851-1170
Fax: (614) 851-8807

JOB NO. 98-130