

JACKSON Twp  
O-36-B

HOCKADEN-LIPES-ROUSCUP, INC.

CONSULTING ENGINEERS


2607 1/2 N. HIGH ST.

COLUMBUS, OHIO

O 36

O 36 B

SITUATED IN THE STATE OF OHIO, COUNTY OF FRANKLIN, TOWNSHIP OF JACKSON AND BEING (SIX) 6 PARCELS OUT OF PART OF LOT 4 OF T.S. SNEAD'S ORIGINAL SURVEY NO. 311, BEING PART OF THAT 100 ACRE TRACT CONVEYED TO PAUL R. PATZER AND REFERRED TO AS TRACT 1 IN DEED BOOK 227, PAGE 180, & RECORDS' OFFICE, FRANKLIN COUNTY, OHIO.

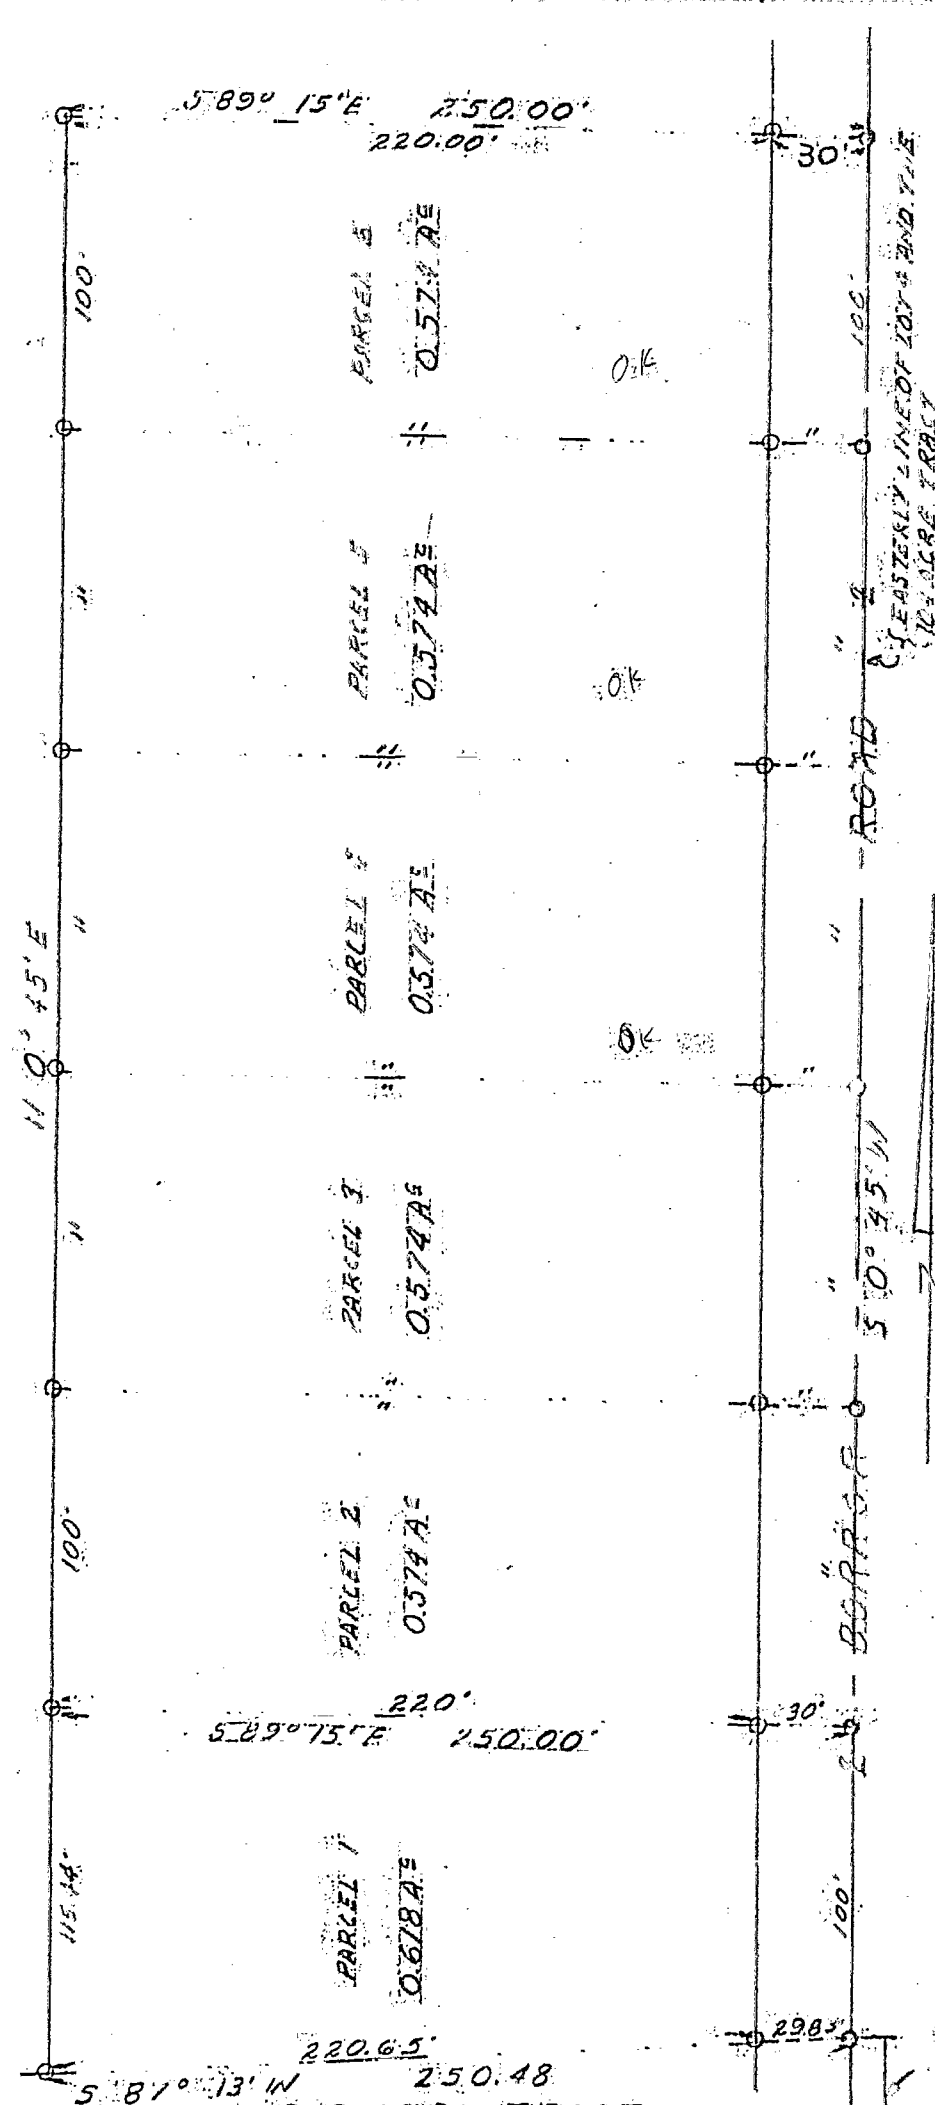

NOTE  
EASTERLY LINE OF 107' 4\"/>

8' 06700

We hereby certify that the foregoing plat was prepared from an actual survey of the premi

SCALE 1" = 30'

DATE: 6-3-66

19105

HOCKADEN-LIPES-ROUSCUP, INC.

REVISED DATED

ORDER NUMBER

ENTVD.	DRAWN	CHECKED
PMT.	RBW	WJM.

By

Registered Surveyor