



SURVEY FOR  
 JOHN S. DELIBERA AND GARY W. LYONS  
 LOCATION  
 JACKSON TOWNSHIP - FRANKLIN COUNTY  
 VIRGINIA MILITARY SURVEY NO. 1105

82106700  
 82356675

0300

SCALE 1" = 200' DATE Nov. 13, 1975 R.B. \_\_\_\_\_ P. 563 LOT No. \_\_\_\_\_

82356650  
 82356675

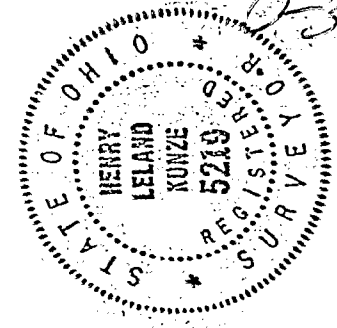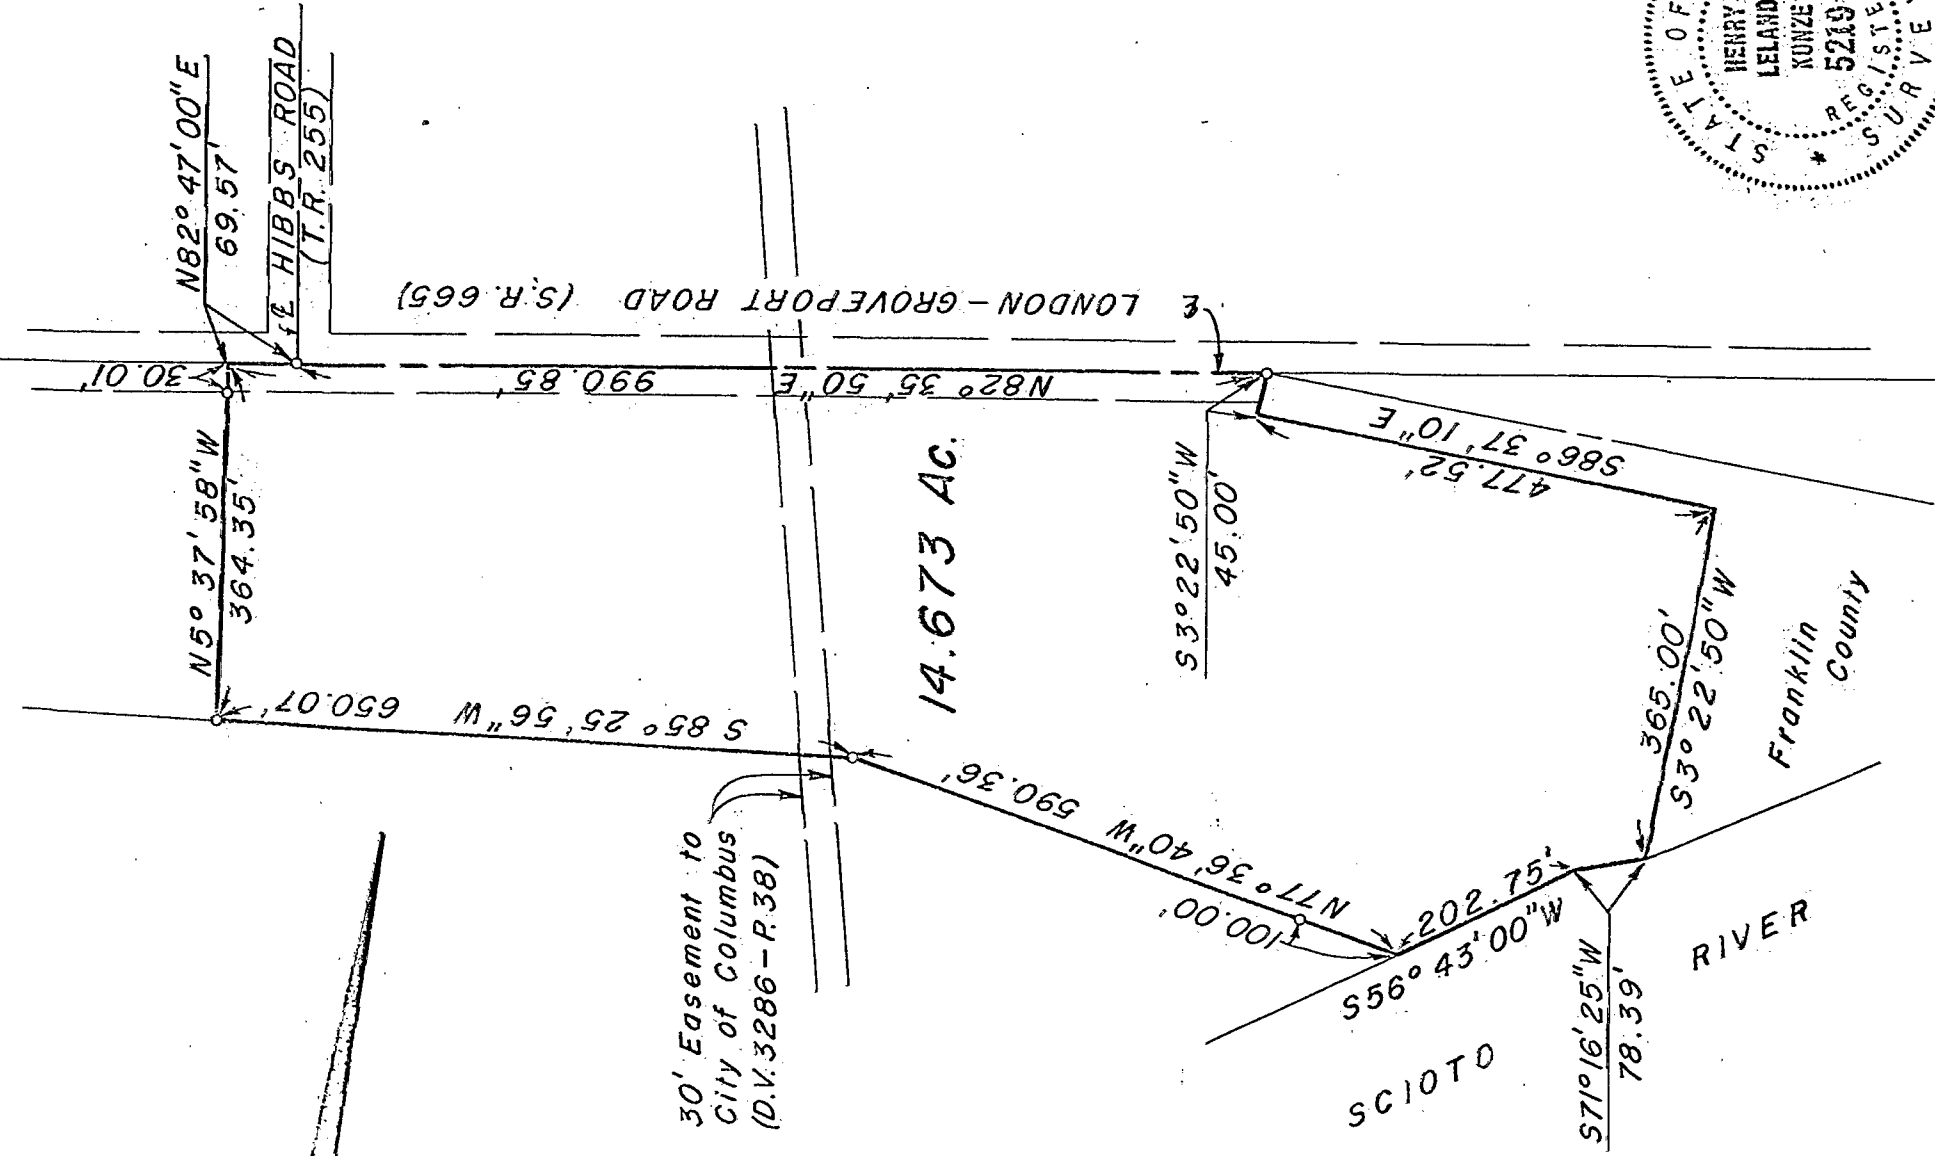

JACKSON TWP

Henry L. Kunze  
 REGISTERED SURVEYOR No. 5219

o - Iron Pin

I HEREBY CERTIFY THAT THE FOREGOING DRAWING WAS PREPARED FROM AN ACTUAL SURVEY OF THE PREMISES.

DRAWN BY M.F.K.

**KUNZE AND ASSOCIATES, INC.**  
 CIVIL ENGINEERS AND LAND SURVEYORS  
 6950 SUNBURY ROAD, WESTERVILLE, OHIO 43081