MYERS SURVEYING CO.
2750 East Main Street, Columbus, Ohio

PLAT OF 0.451 ACRE TRACT IN V.M.S. #6115, JACKSON TWP., FRANKLIN CO. OHIO
V.M.S. # 478

FOR

INTER COUNTY TITLE AND/OR
THE KISSELL COMPANY

0-34-G

1728 Page 283
1" = 30'

0 34-G

Franklin Co. Rec. Office
11 · 3 · '66
Rev. 1 · 10, 67

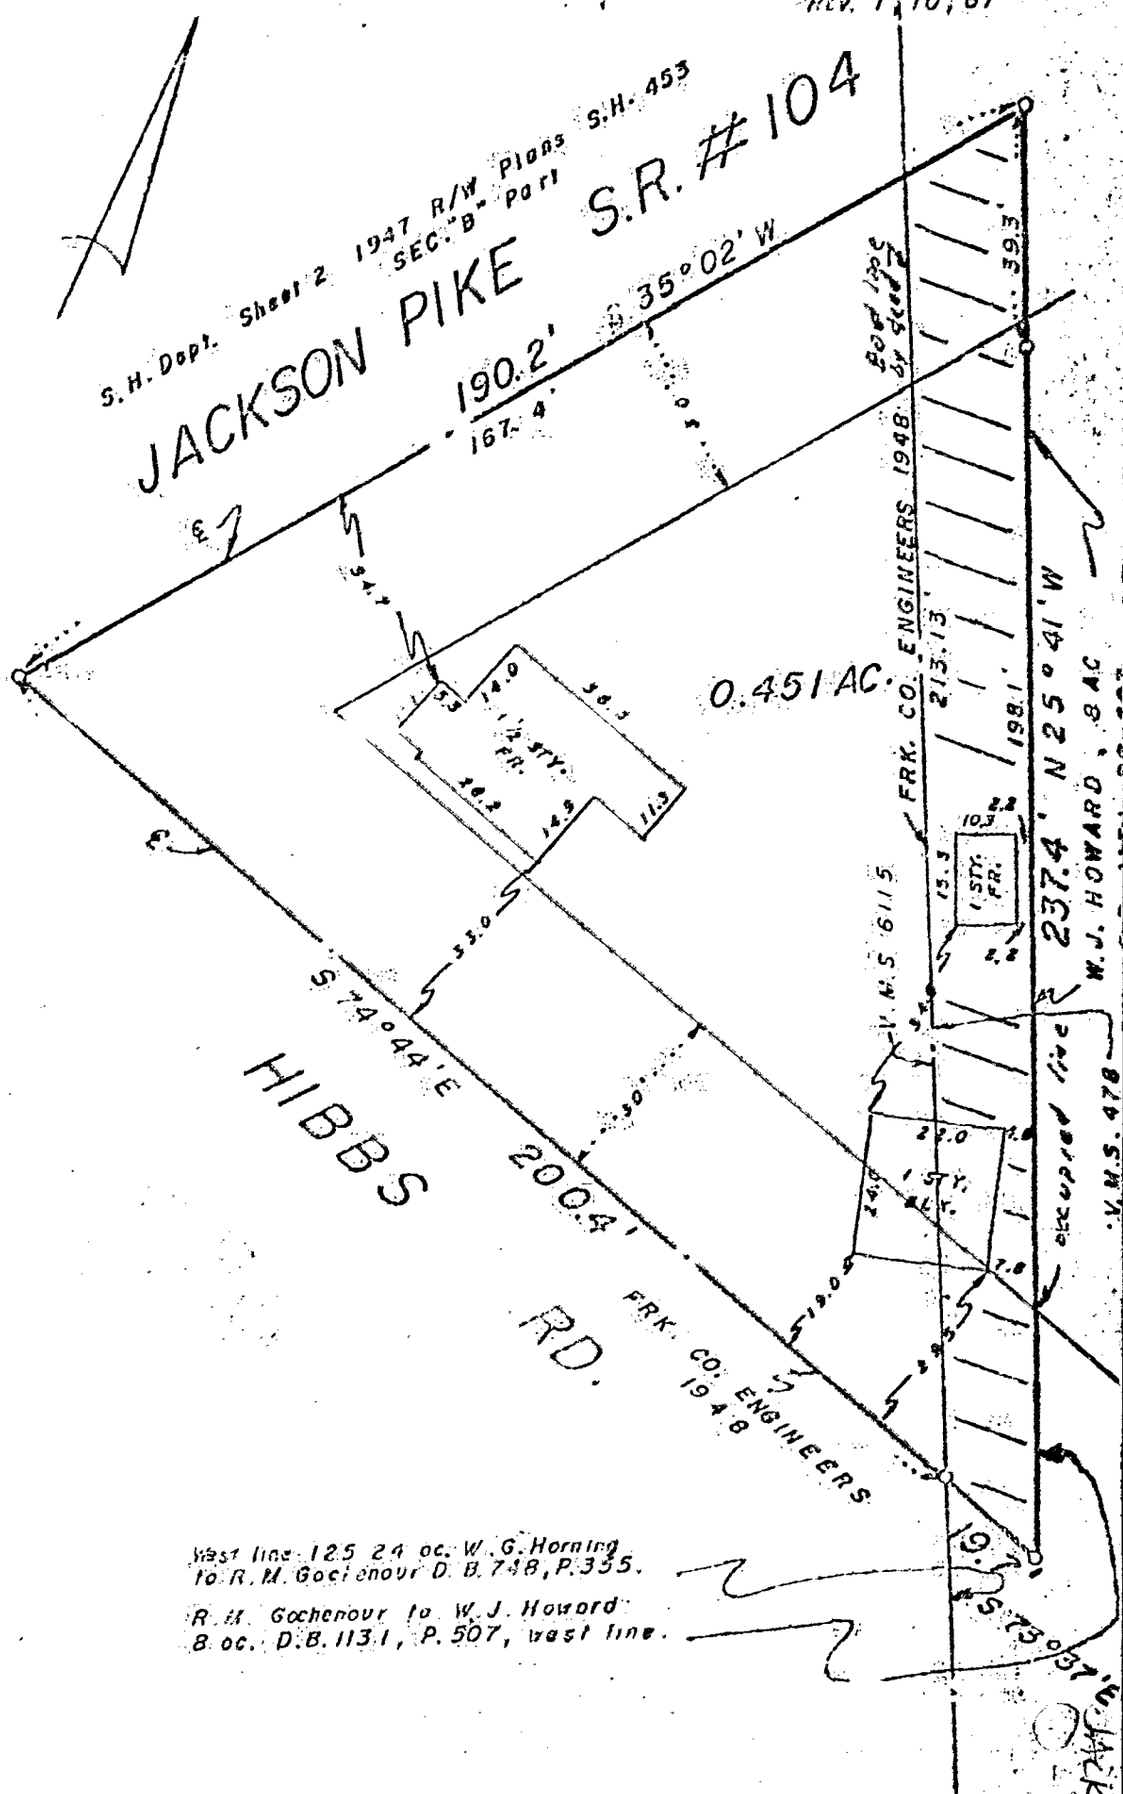

West line 125.24 ac. W.G. Horning to R.M. Gochenour D.B. 748, P. 335.

R.M. Gochenour to W.J. Howard 8 ac. D.B. 1131, P. 507, west line.

We hereby certify that the foregoing plat was prepared from an [illegible] of the premises. No side line of principal building [illegible] extension shown. Iron pins not set and [illegible] located [illegible]

MYERS SURVEYING CO.
BY [signature]
Registered Surveyor