


HAMILTON TWP
O-26-A

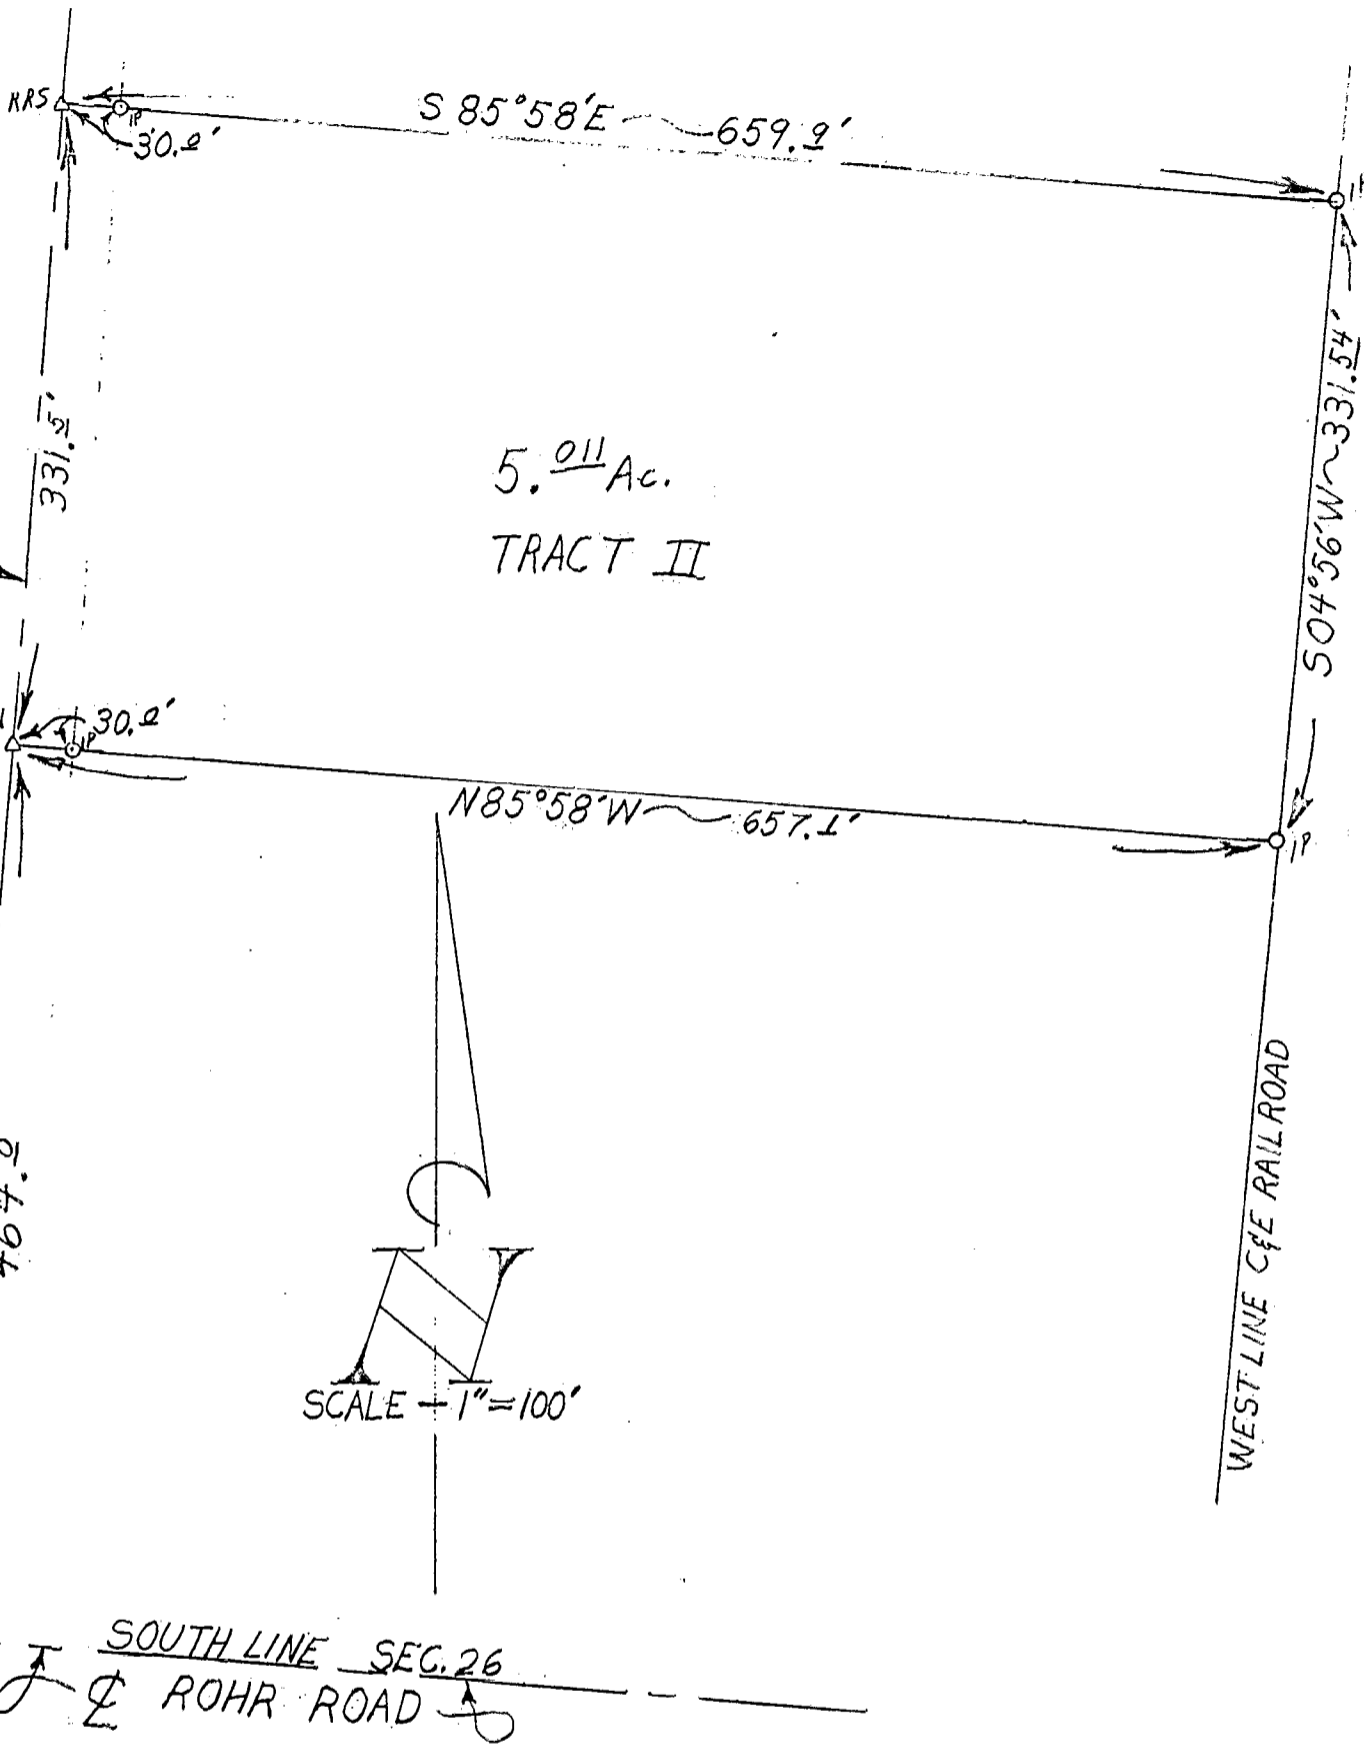

5.011 Ac.
TRACT II


BIXBY

SOUTH LINE SEC. 26

ROHR ROAD

SURVEY OF 5.011 ACRES IN HAMILTON
TOWNSHIP, FRANKLIN COUNTY, OHIO. FOR

RAYMOND DILL

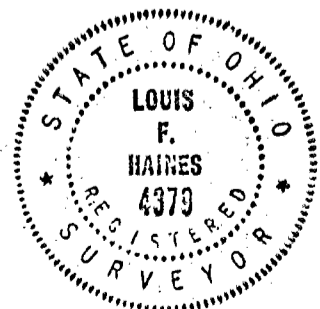


Louis F Haines

132 E. Main Street
Lancaster, Ohio 43130
Phone 654-7306

I HEREBY CERTIFY THE PLAT SHOWN HEREON
IS CORRECT AS SURVEYED BY US.

DATE: APRIL 12, 1979

SIGNED: Louis F. Haines

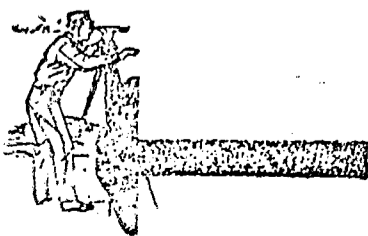

83856 725
84106 725