

ACK-504 TWP  
0-36-E

56-E


Survey of 5.661 acres  
in Vms #615, Jackson Township,  
Franklin Co., Ohio: for

Therill Clagg



**Louis F Haines**

354 Kessler Street  
Groveport, Ohio 43125  
Phone 837-2181

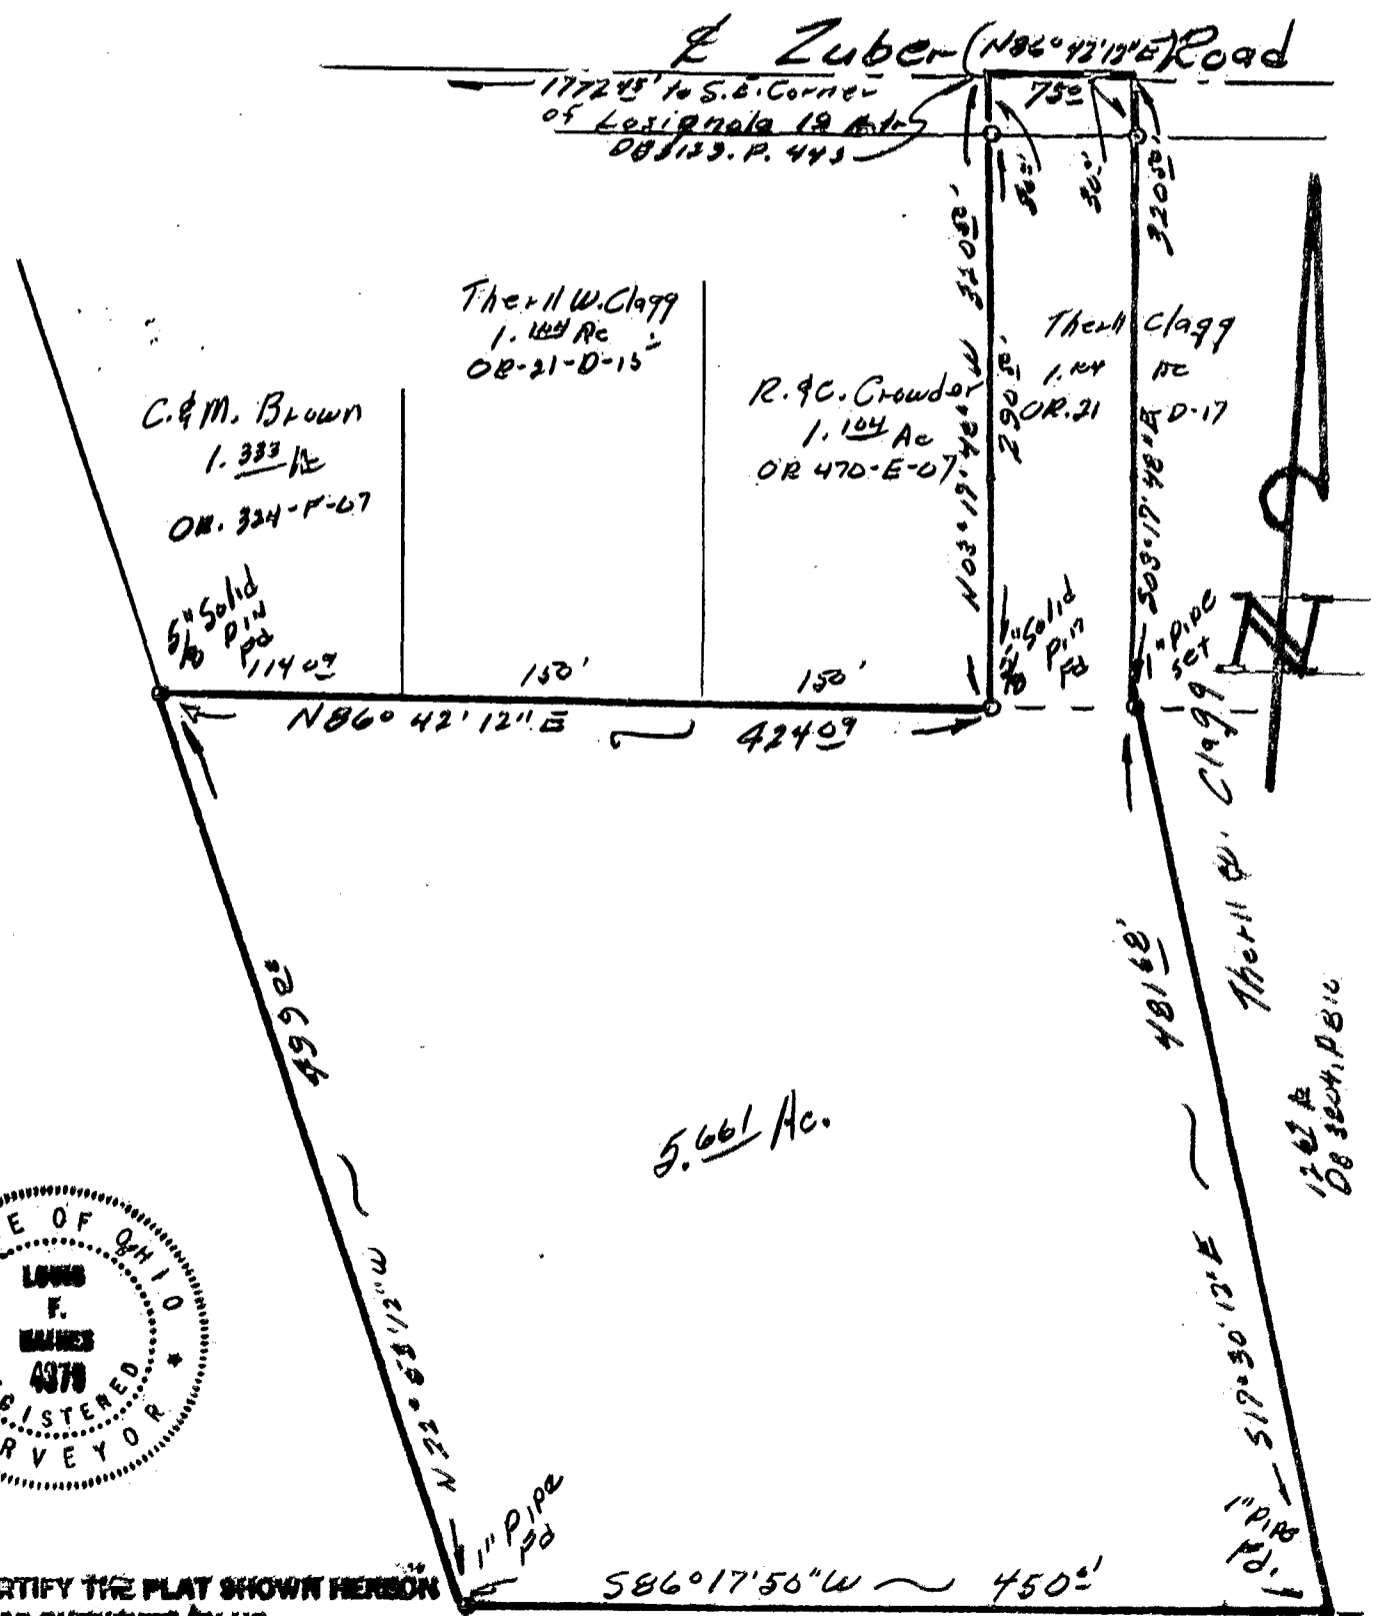

05925818  
05925818



HEREBY CERTIFY THE PLAT SHOWN HERON  
IS CORRECT AS SURVEYED BY US.

DATE: August 4, 1984 Wm J. Grossman 354 N  
D.B. 3700, P. 233

SIGNED: Louis F. Haines