


81106650 81356650 81606625
 81106625 81356625

0-36-~~3~~ 0-36-E
 JACKSON Twp.

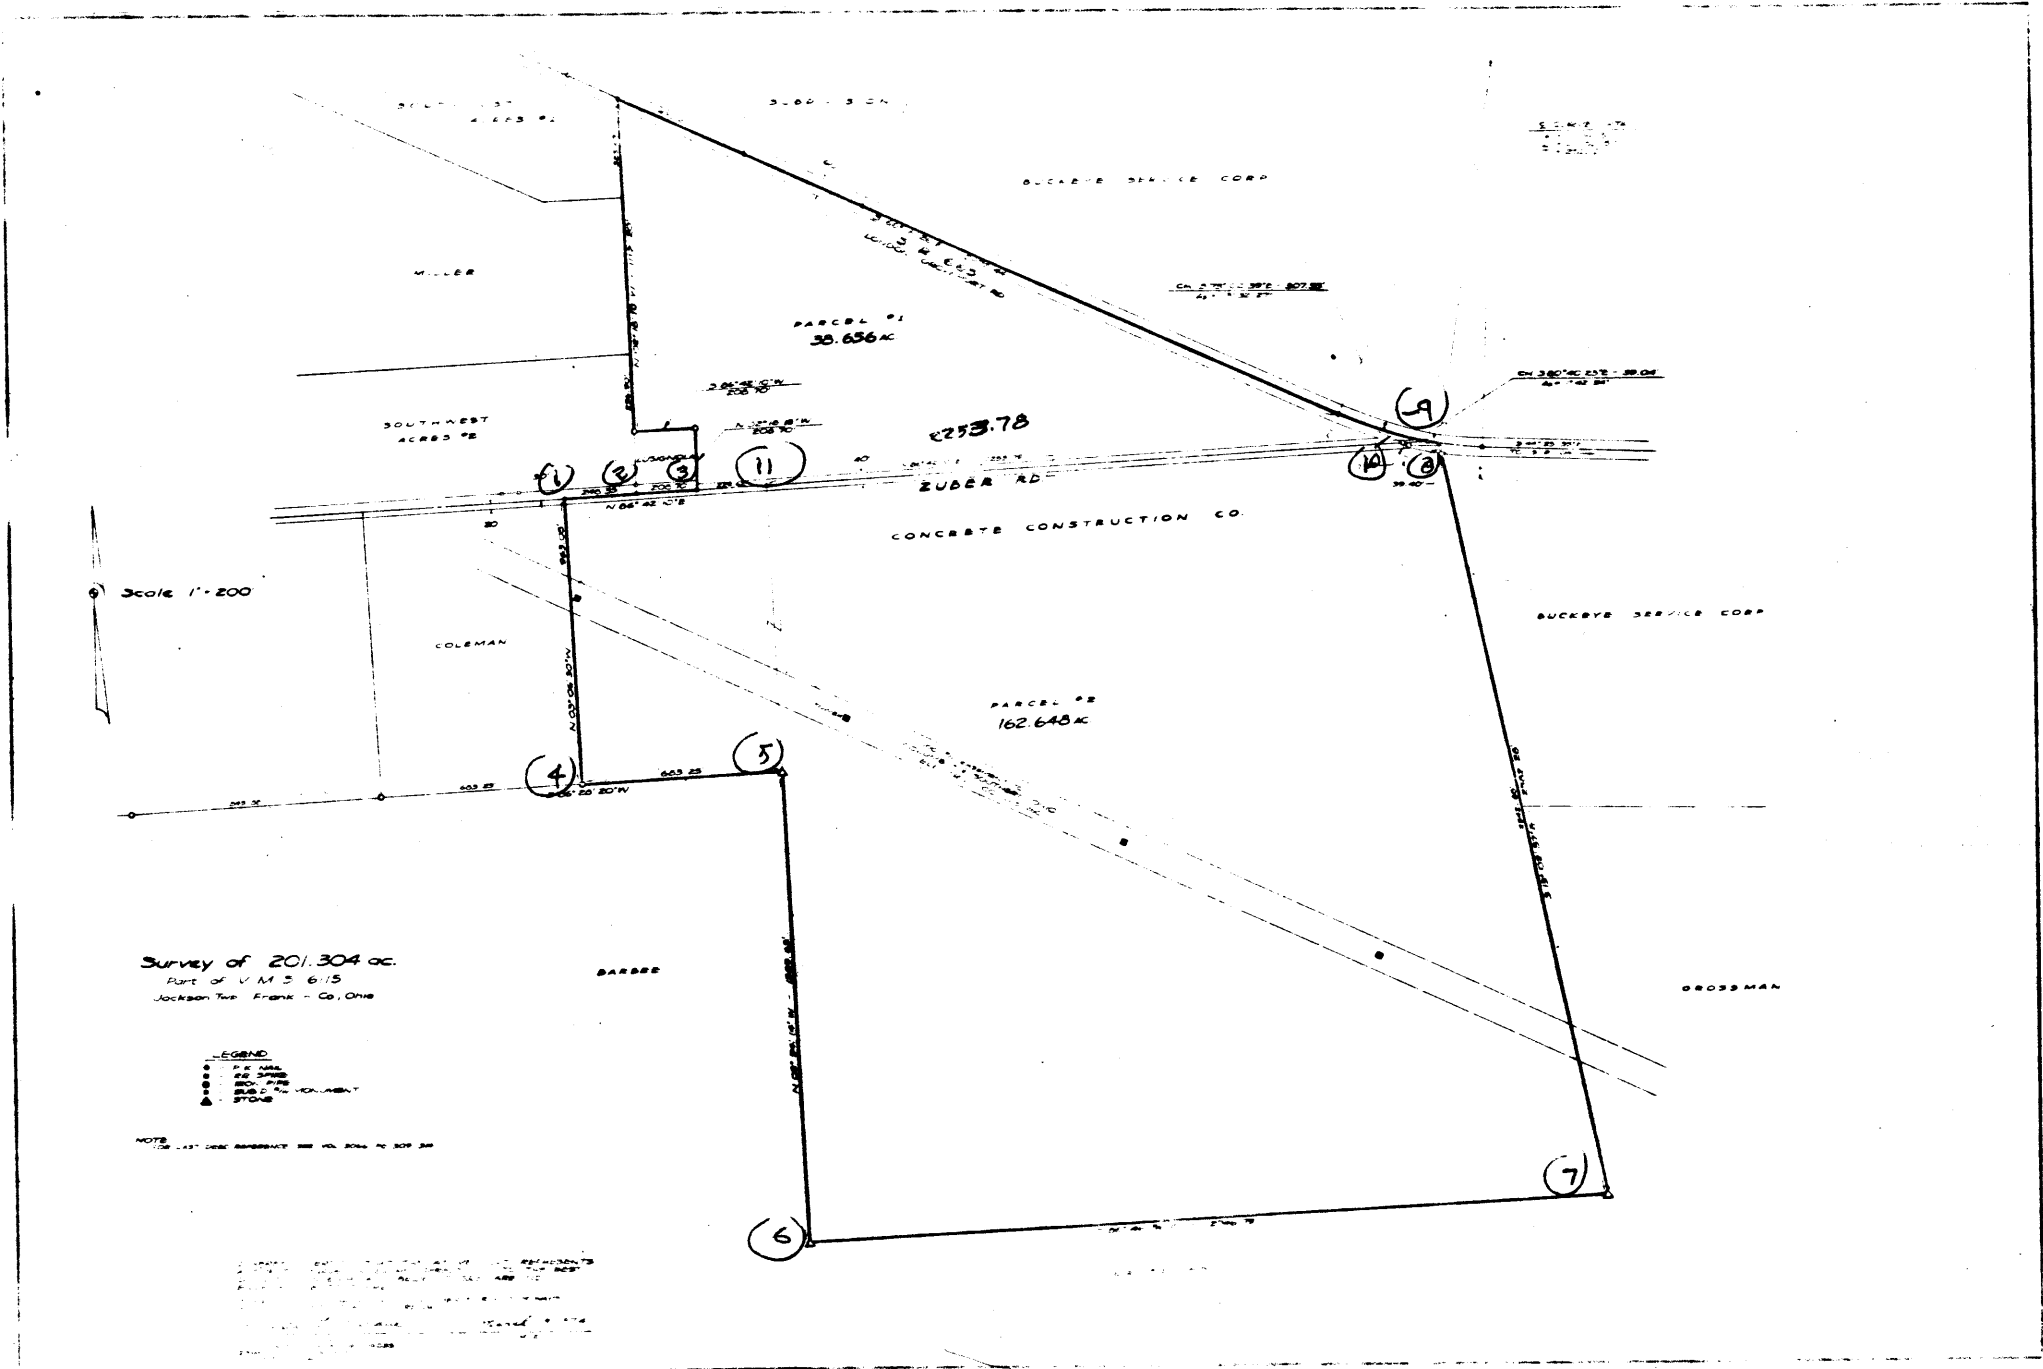

5040 120 062 038 5 ZUBER RD 1974 0365 030