

JACKSON TRIP  
0-30-e

SURVEY FOR  
JOHN S. DELIBERA AND GARY W. LYONS  
LOCATION  
JACKSON TOWNSHIP - FRANKLIN COUNTY  
VIRGINIA MILITARY SURVEY NO. 1105

(9) 30

SCALE 1" = 50' DATE Nov. 13, 1975 P.B. P. D.V. 3327 P. 563 LOT No.

030

0300

1975

RD














2613.63' To South  
Line V.M.S. 1105

LONDON - GROVEPORT ROAD (S.R. 665)

30.00' N5° 37' 58" W 150.00' 30.00'

210.00'


210.00'

0.723 Acres

S85° 25' 56" W

N85° 25' 56" E

S5° 37' 58" E 150.00'

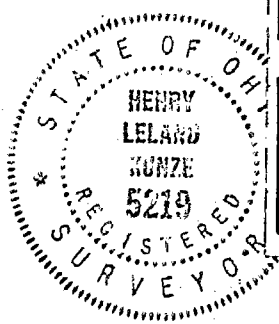

82.06650

o - Iron Pin

I HEREBY CERTIFY THAT THE FOREGOING DRAWING WAS PREPARED FROM AN ACTUAL SURVEY OF THE PREMISES.

DRAWN BY M.F.K.

Henry L. Kunze  
REGISTERED SURVEYOR No. 5219

KUNZE and ASSOCIATES, INC.  
CIVIL ENGINEERS and LAND SURVEYORS  
6950 SUNBURY ROAD, WESTERVILLE, OHIO 43081