


SURVEY FOR
 JOHN S. DELIBERA AND GARY W. LYONS
 LOCATION
 JACKSON TOWNSHIP - FRANKLIN COUNTY
 VIRGINIA MILITARY SURVEY NO. 1105

8210650
 82356650

SCALE 1" = 200' DATE Nov. 13, 1975 P.B. _____ P. _____ D.V. 3327 P. 563 LOT No. _____

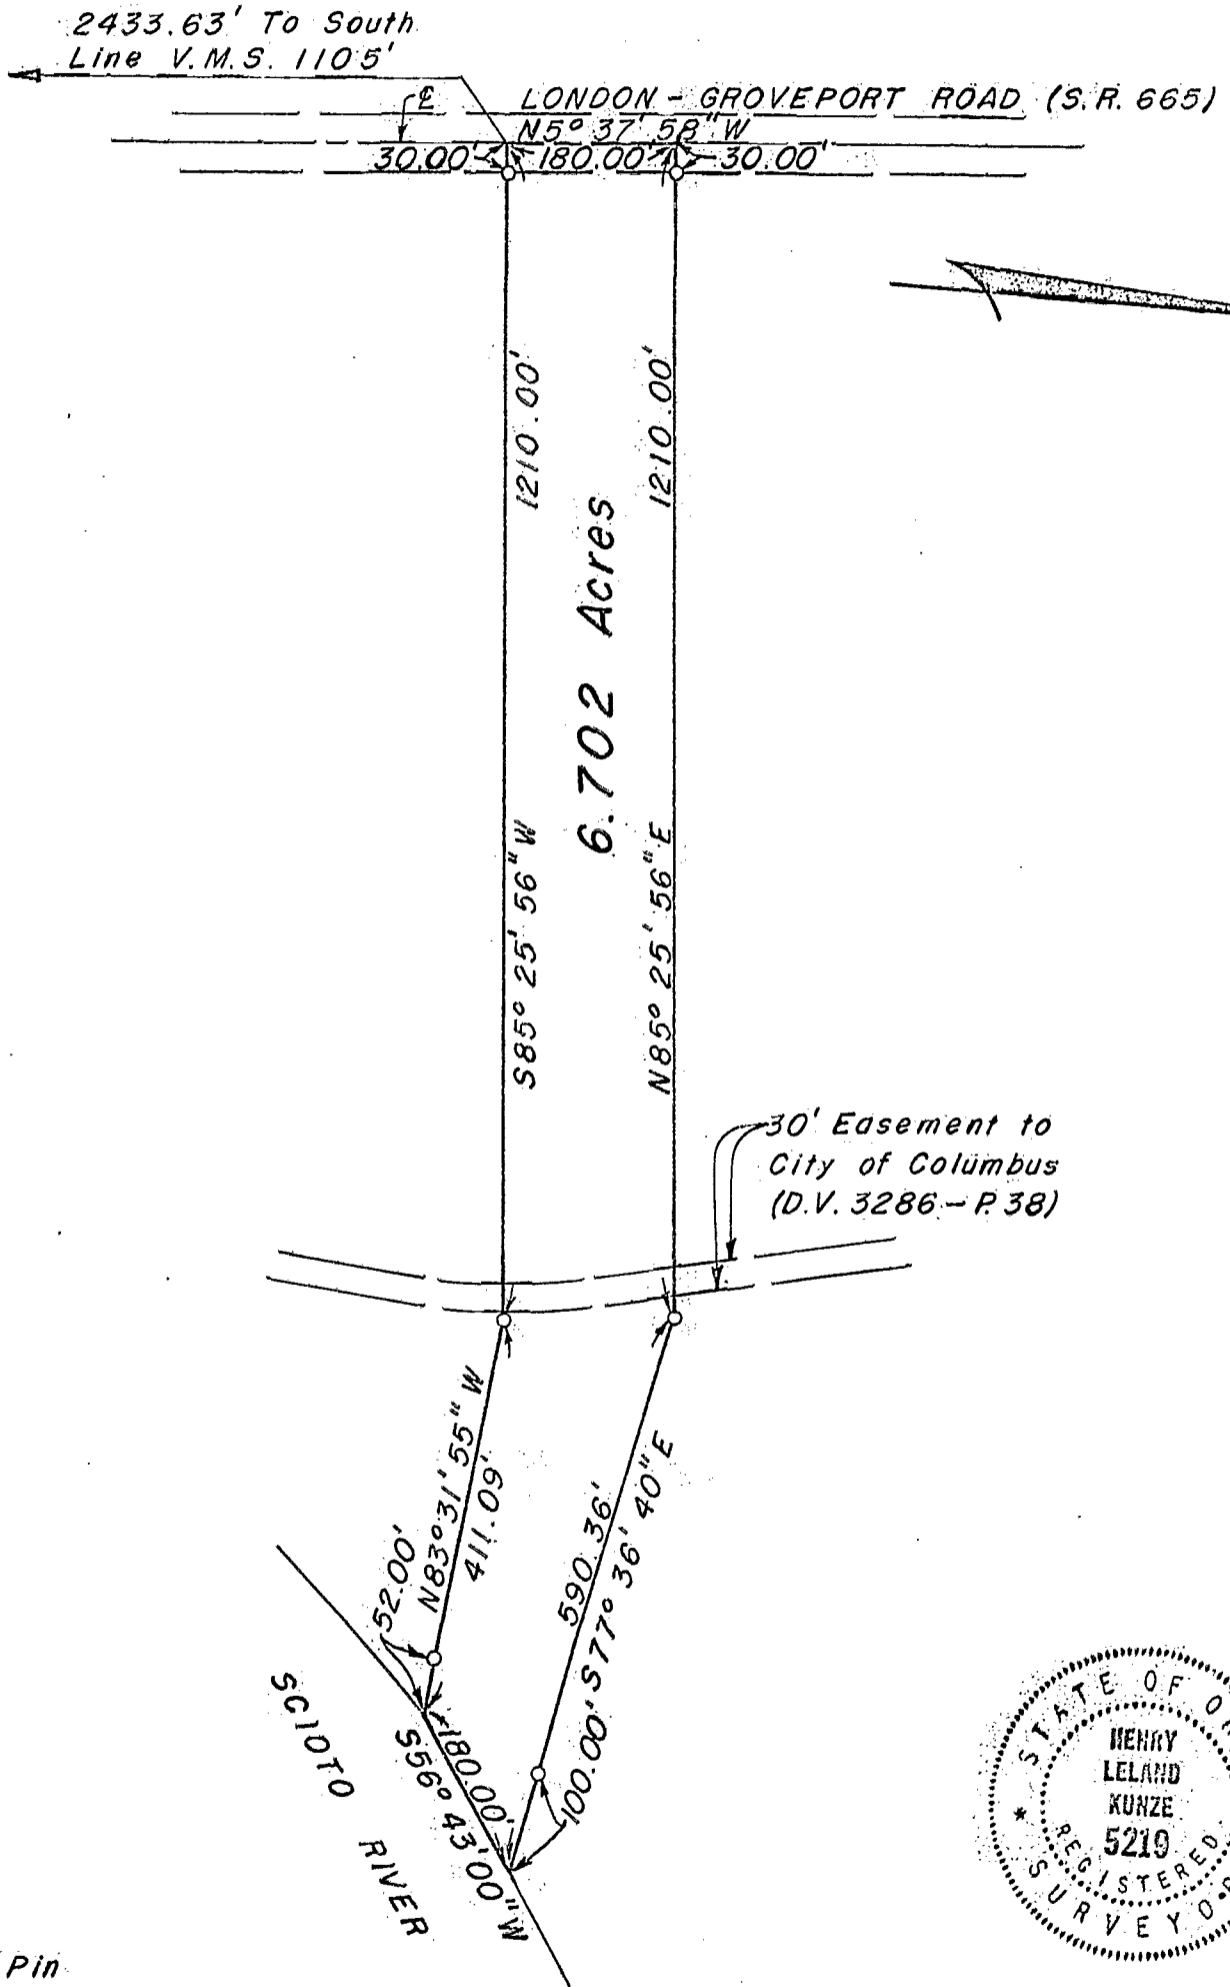

o - Iron Pin

I HEREBY CERTIFY THAT THE FOREGOING DRAWING WAS PREPARED FROM AN ACTUAL SURVEY OF THE PREMISES.
 DRAWN BY M.F.K.

Henry L. Kunze
 REGISTERED SURVEYOR NO. 5219

O-30-C Jackson Twp.

KUNZE and ASSOCIATES, INC.
 CIVIL ENGINEERS and LAND SURVEYORS
 6950 SUNBURY ROAD, WESTERVILLE, OHIO 43081