


SURVEY FOR
 JOHN S. DELIBERA AND GARY W. LYONS
 LOCATION
 JACKSON TOWNSHIP - FRANKLIN COUNTY
 VIRGINIA MILITARY SURVEY NO. 1105

() - 50 - C

SCALE 1" = 50' DATE Nov. 13, 1975 P.B. _____ P. _____ D.V. 3327 P. 567 LOT No. _____

2880
 126
 028
 026
 S
 LONDON
 GROVEPORT
 1975
 0300
 030

82:06650
 82:06675

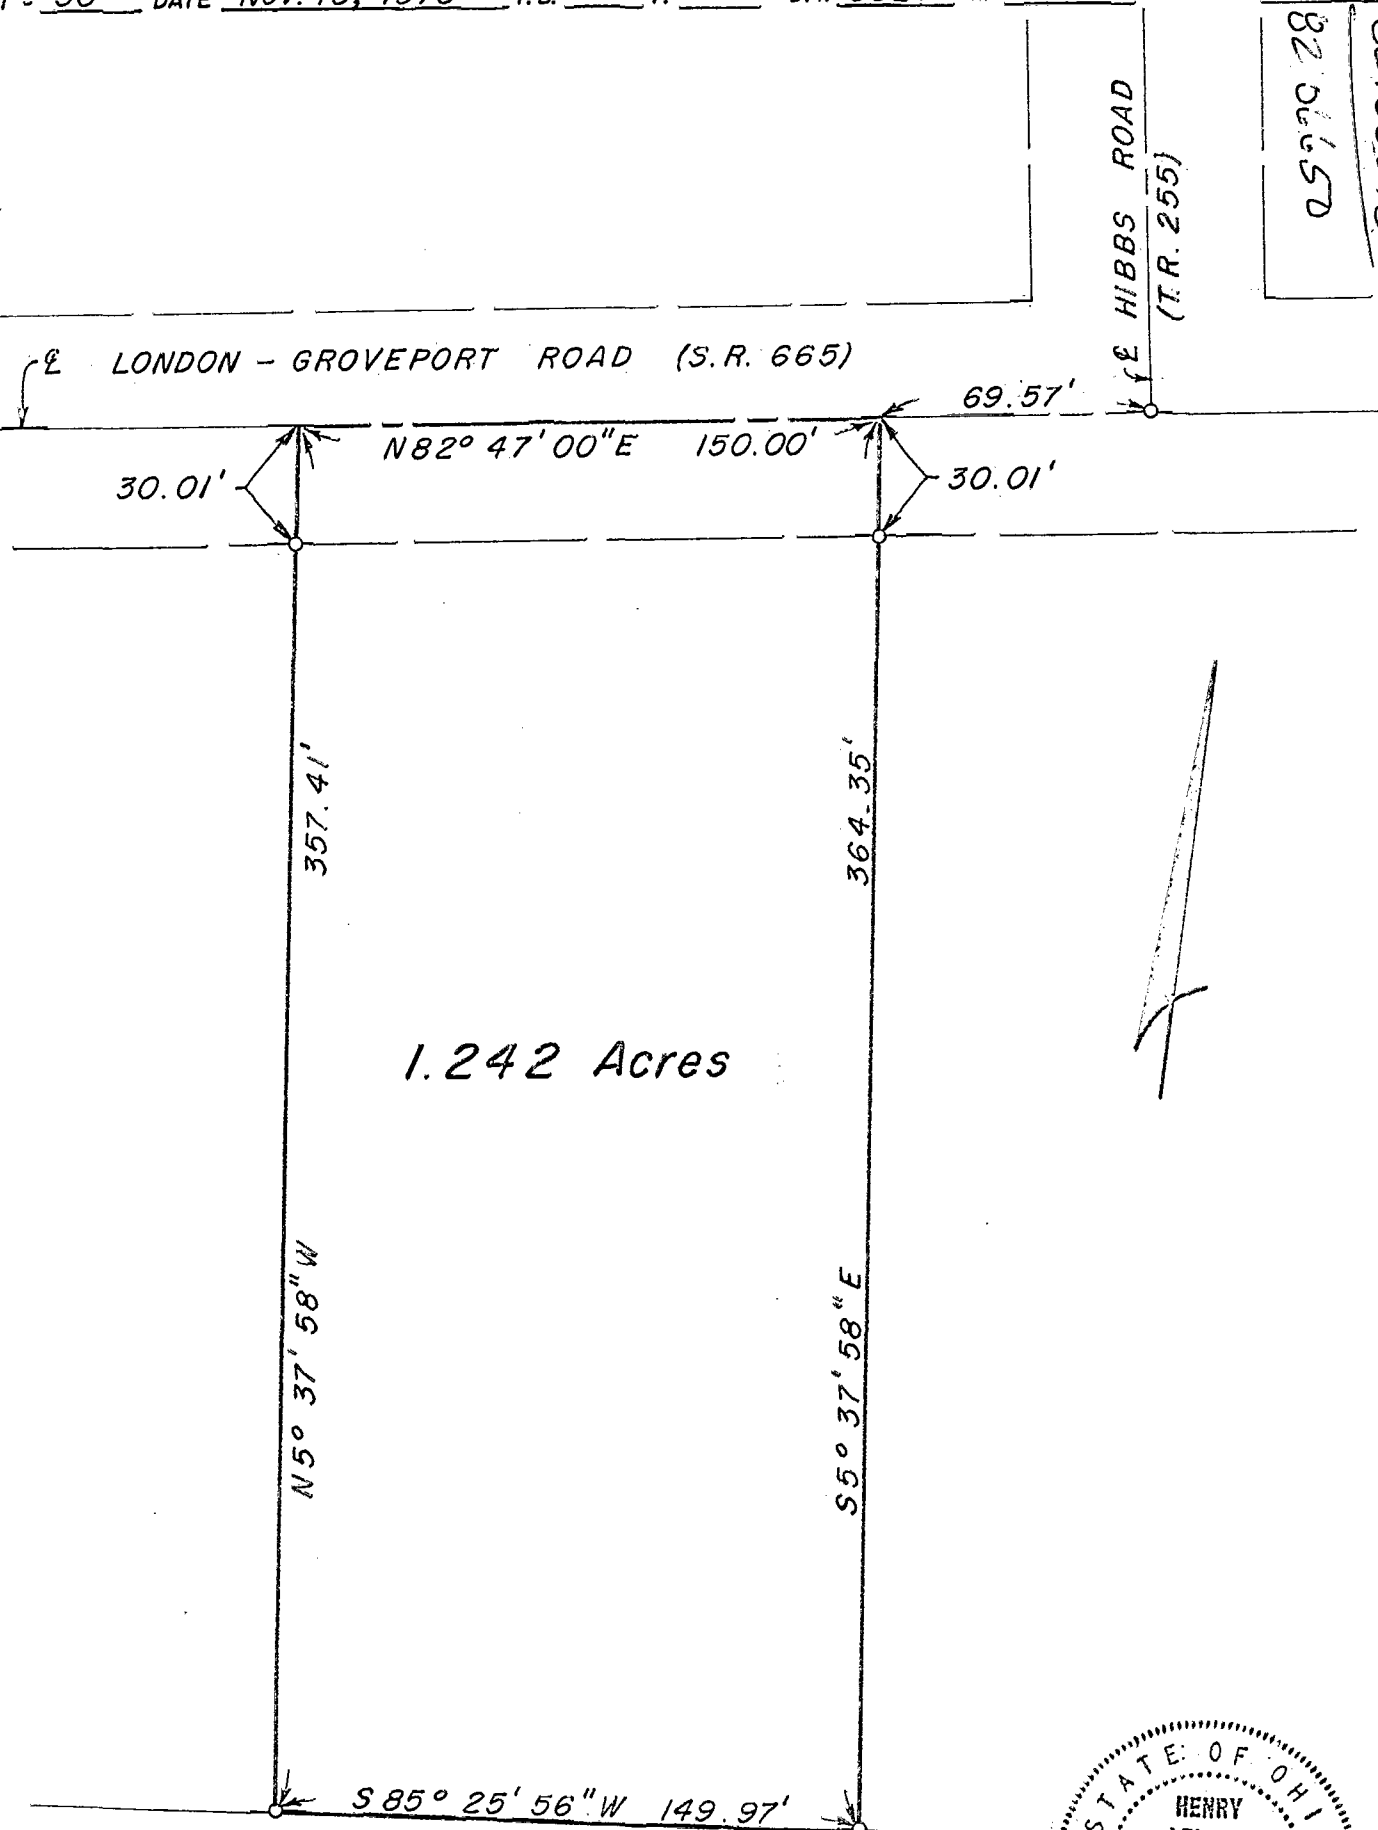

1.242 Acres



JACKSON TWP

Iron Pin

REBY CERTIFY THAT THE FOREGOING DRAWING WAS PREPARED
 AN ACTUAL SURVEY OF THE PREMISES.

Henry L. Kunze
 REGISTERED SURVEYOR No. 5219

DRAWN BY M.F.K.