



North R. orig. 225.536 ac

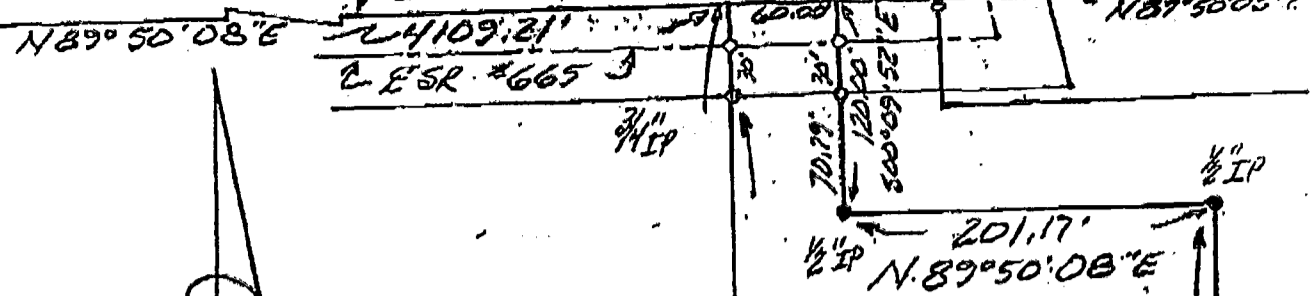

ESR #104

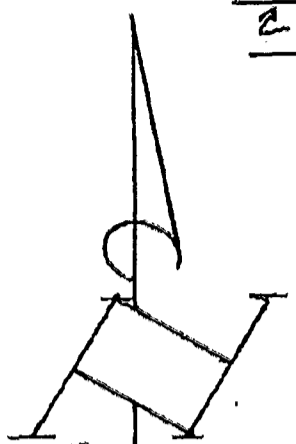

Scale 1"=100'

0 50 100 150 200 250 300

Basis of Bearings:
North R. of Original
225.536 ac DR 59-D-07
as N 89° 50' 08" E

Edwin L. S. Alberta Dudley

5.105 ac.
OR 29055-A-18

SURVEY OF 6.503 ACRES
in VMS 1108, Jackson Twp.,
Franklin Co., Ohio:
FOR
Daniel Slane

TRACT "Y"
6.503 ACRES



HAINES SURVEYORS
354 Kessler Street
Groveport, Ohio 43125
Phone: 837-2181

I hereby certify that the plat shown herein was prepared from an actual field survey, under my supervision and that said plat correctly represents said survey.
DATE May 15, 1995 Louis E. Haines

City of Columbus
150 ac.
OB 3447 Pg 712

1183.30'
1134.37'
N 00° 09' 52" W
500° 08' 30" E
1052.63'
OR- 982-D-14
5.673 ac.
Richard M. Stickle
1/2" IP

ACCESS
182
089176
529 90' 28'
0-30-C