
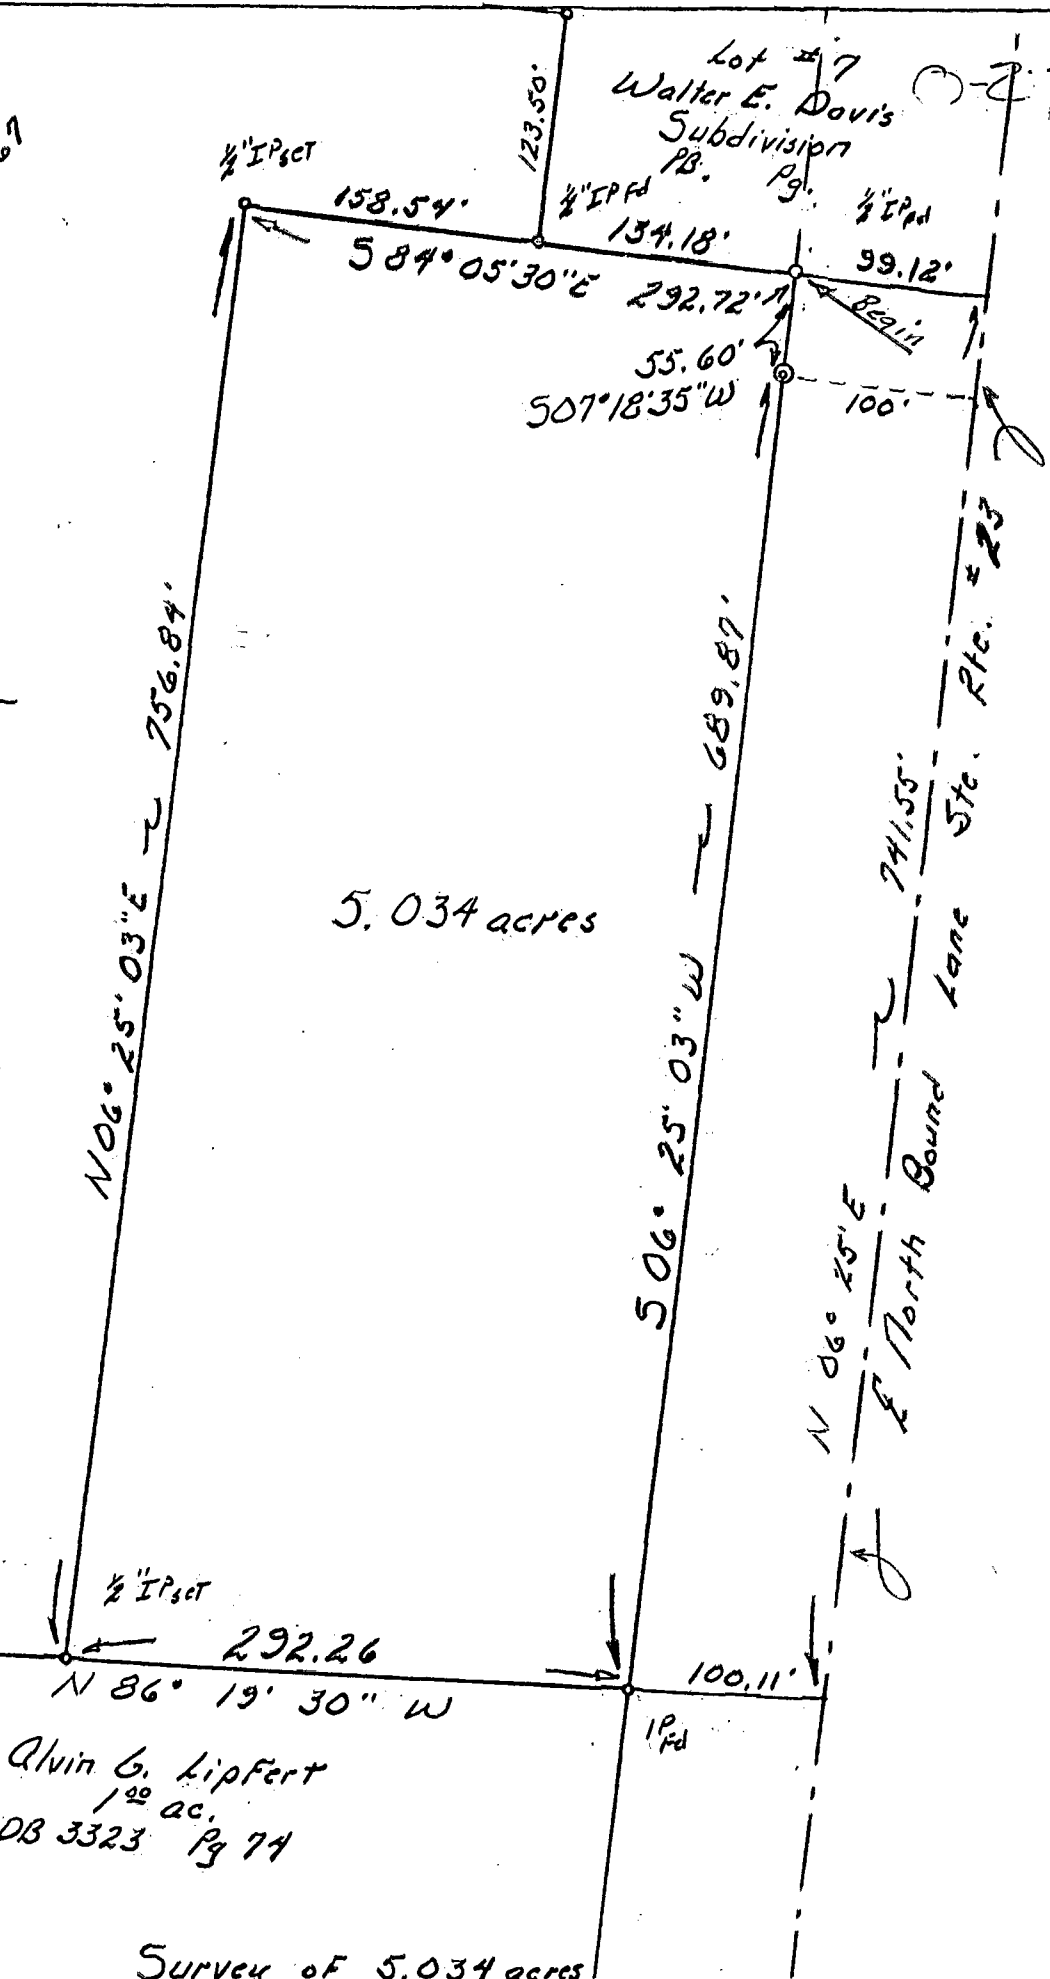
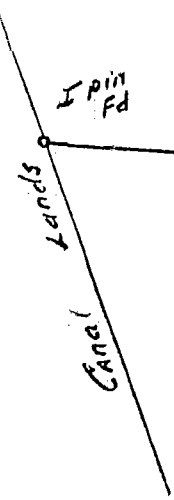


HAMILTON TWP  
0-27-A

Walter E. Davis  
31.04 ac  
Pg 467  
DB. 1686

Lot # 7  
Walter E. Davis  
Subdivision  
Pg. Pg.

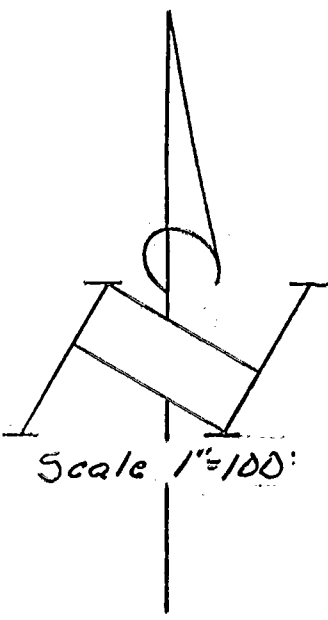


5.034 acres

Alvin G. Lipfert  
1.22 ac.  
DB 3323 Pg 74

Survey of 5.034 acres  
in Sec. 4, Twp. 3, Rge. 22,  
Hamilton Twp., Franklin Co.,  
Ohio: FM

Walter E. Davis

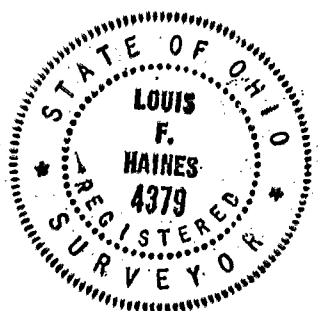

**Louis F Haines**

354 Kessler Street  
Groveport, Ohio 43125  
Phone 837-2181

I HEREBY CERTIFY THE PLAT SHOWN HEREON  
IS CORRECT AS SURVEYED BY US.  
DATE: Oct 5, 1925  
SIGNED: Louis F. Haines

82606650



J-927