

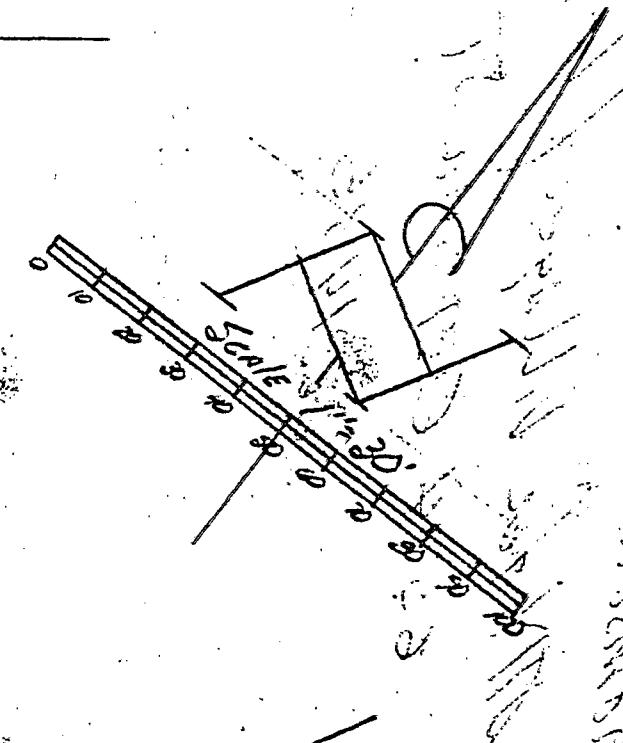


E COMMENCE STREET 50' R/W

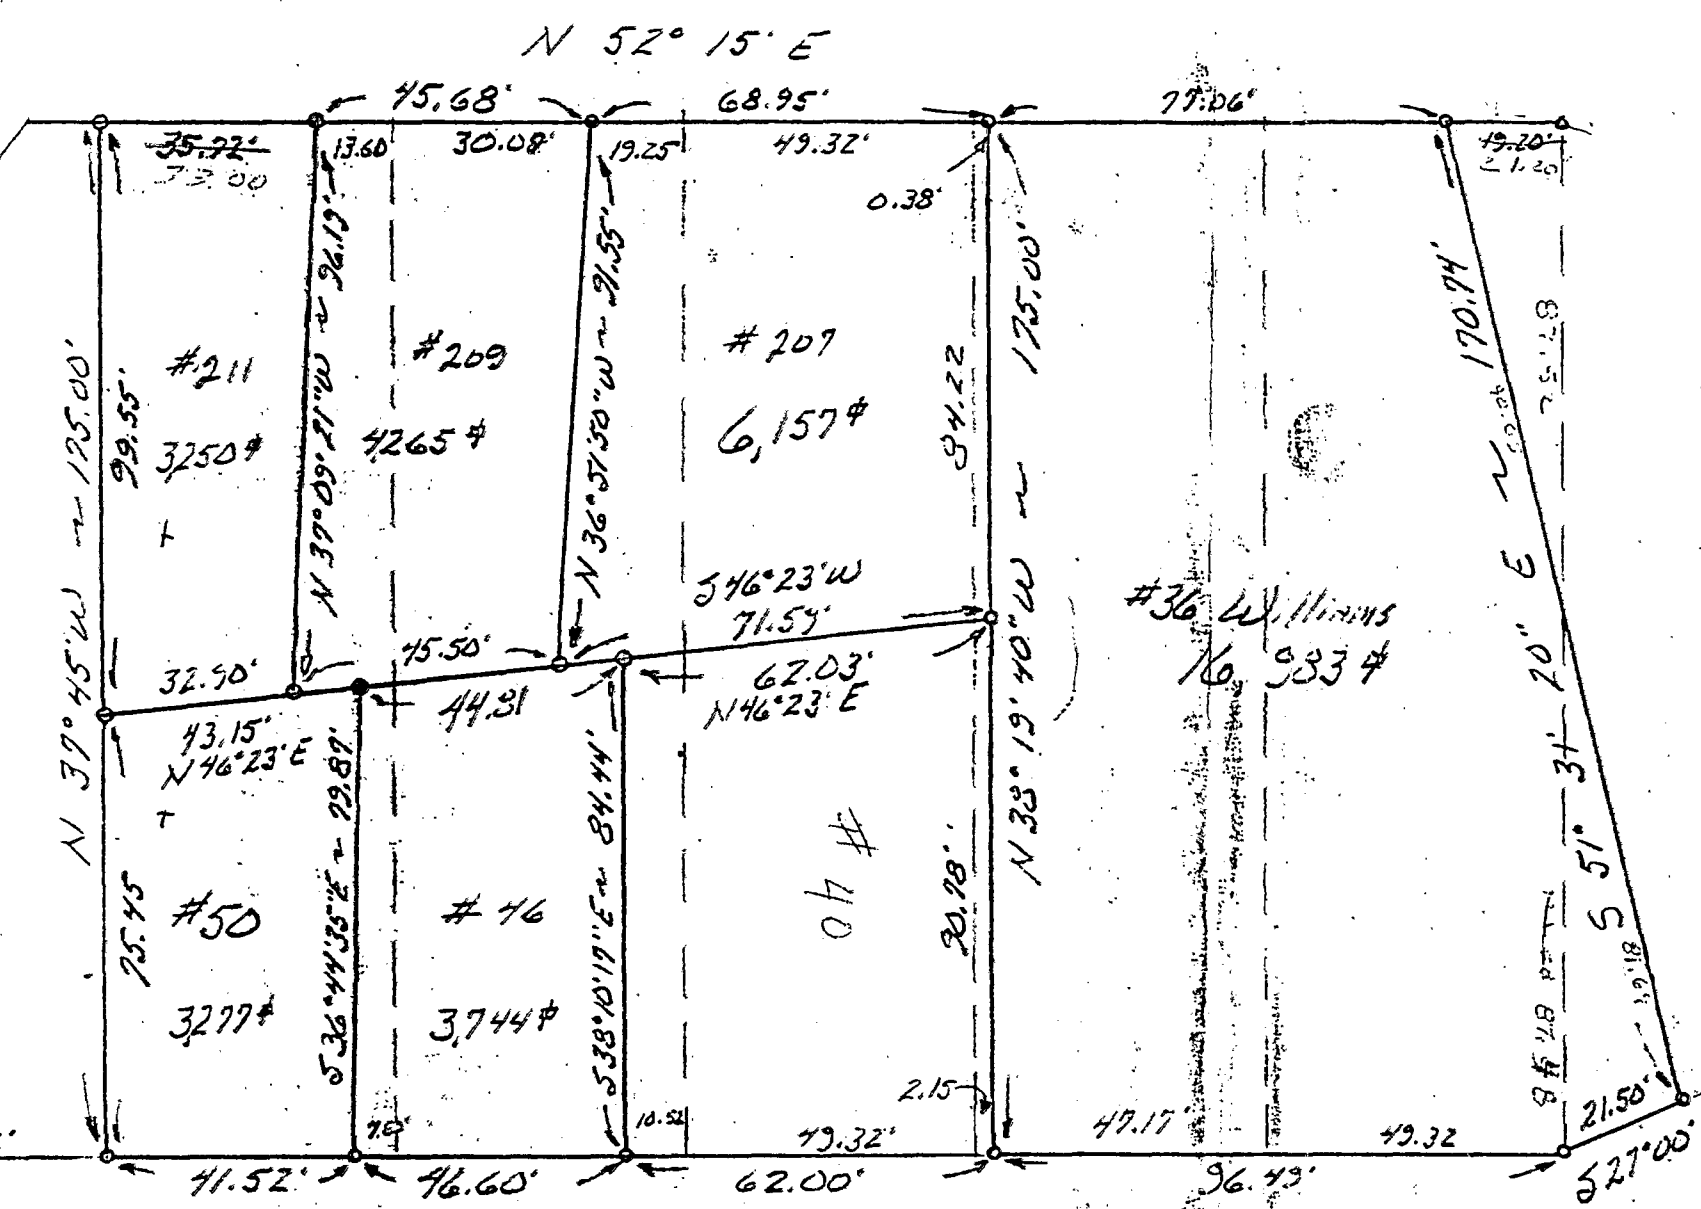


E Williams STREET 66' R/W

Survey of Six Tracts,
 Lookbourne, Franklin, Ohio
 for:
WM. BLATR et al.

 

Louis F Haines
 354 Kessler Street
 Groveport, Ohio 43125
 Phone 837-2181

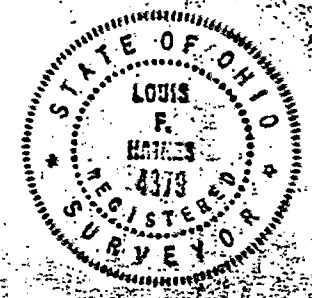

I HEREBY CERTIFY THE PLAT SHOWN HEREON
 IS CORRECT AS SURVEYED BY US.
 DATE: April 10, 1999
 SIGNED: Louis F. Haines