


18385 6175
18385 6800

LOT NO. 217 AND 218
WALNUT HEIGHTS
HAMILTON TOWNSHIP

M-87

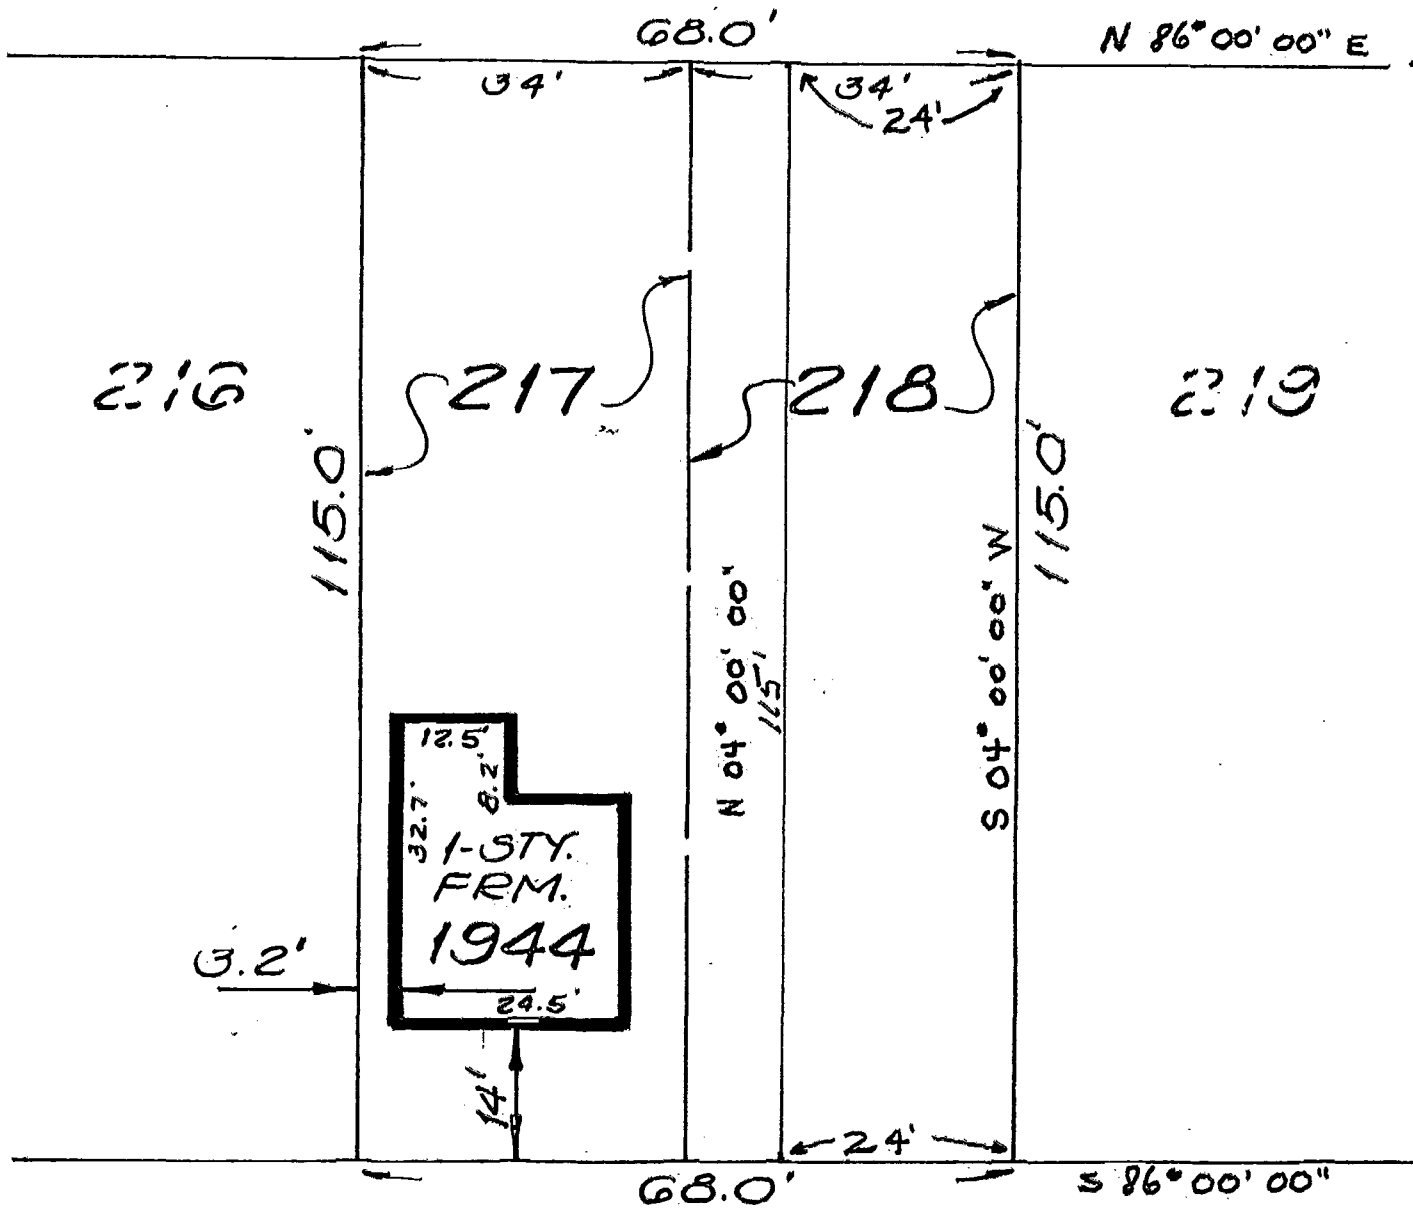

REES AVENUE 50'
WOOD STREET