HAMILTON
83 606 575

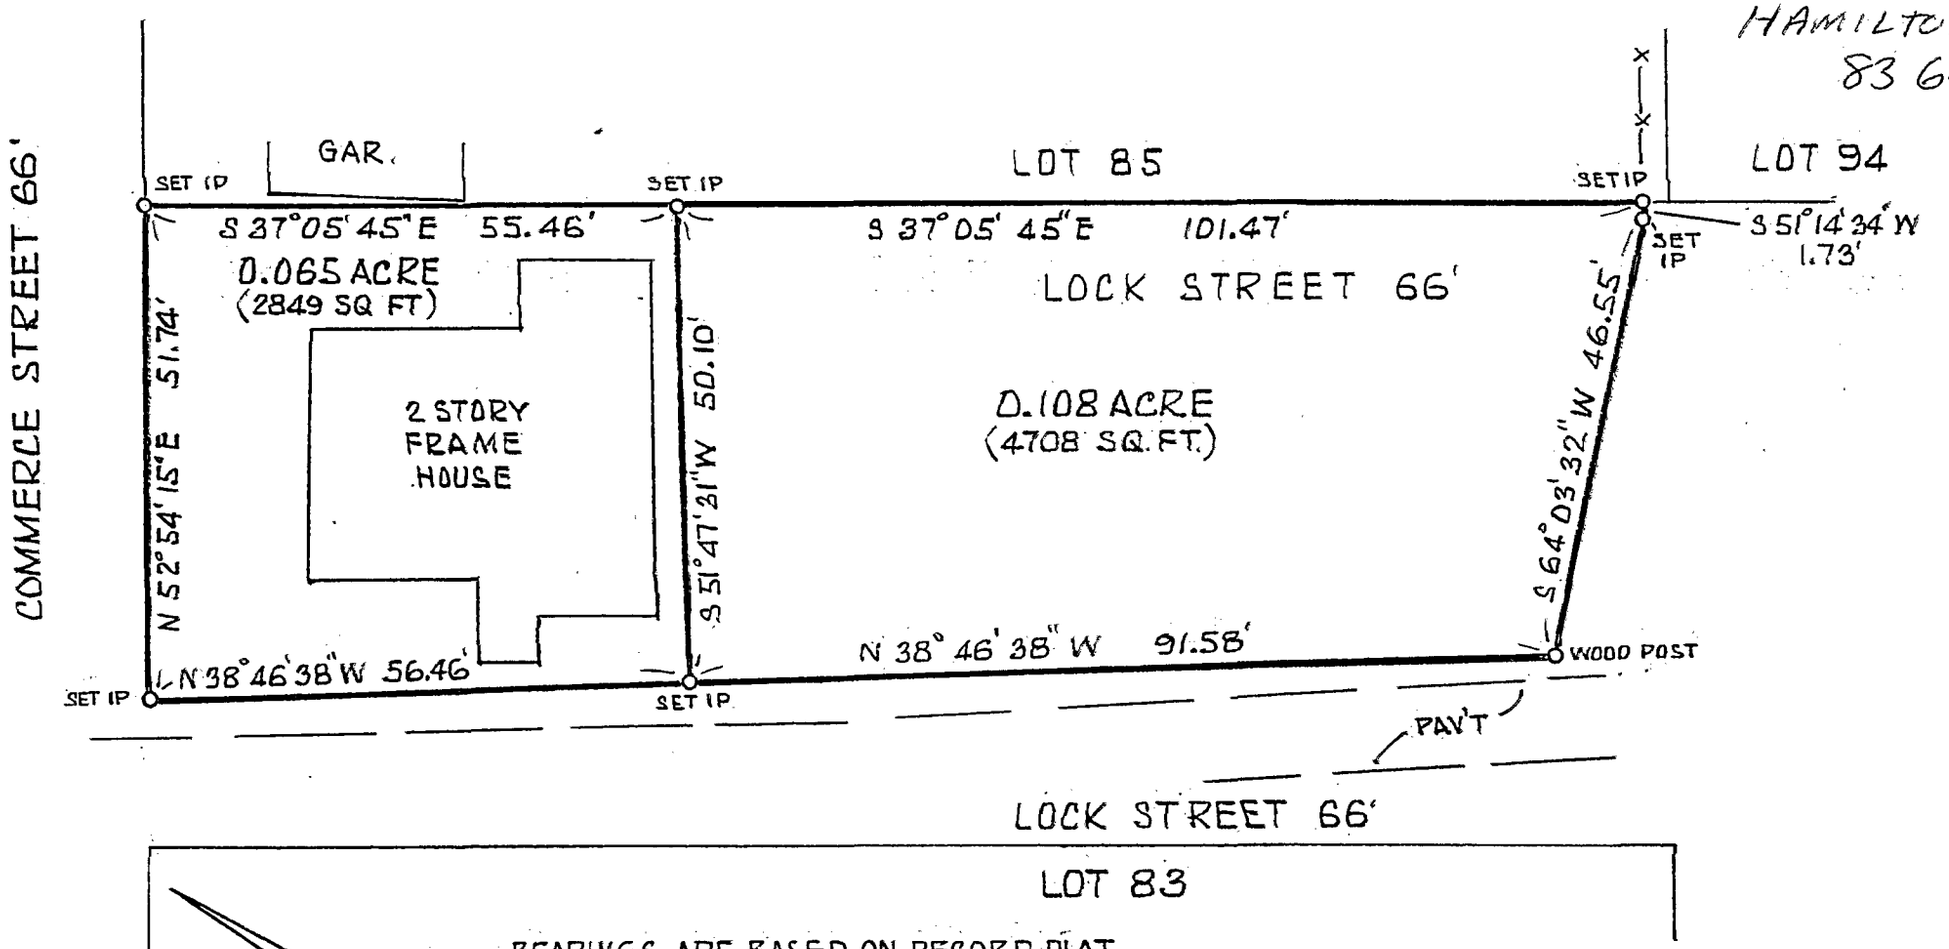

BEARINGS ARE BASED ON RECORD PLAT CALL BEARING OF "DUE NORTH" FOR THE EAST LINE OF THE VILLAGE AS DETERMINED FROM FOUND STONES MONUMENTING SAME. PLAT OF VILLAGE OF RECORD IN P.B. 5 P 56 THROUGH 59 INCL.

SET IP'S ARE 5/8" X 30" REBARS WITH YELLOW PLASTIC CAPS EMBOSSED "THOMAS ENGR & SURVEYING."

0 20' 40' 60'

SCALE 1" = 20'

PLAT OF SURVEY
LOCK STREET TRACTS
VILLAGE OF LOCKBOURNE OHIO

MARCH 1997 1638-96

THE THOMAS ENGINEERING & SURVEYING CO.

Robert G. Watts

ROBERT G. WATTS RPLS#4138