




**FRANKLIN CONSULTANTS, INC.**

2700 EAST DUBLIN-GRANVILLE ROAD, SUITE 500  
COLUMBUS, OHIO 43231  
(614) 891-6000 FAX: (614) 891-6003  
E-MAIL: mail@franklinconsultants.com

SITUATED IN THE STATE OF OHIO, COUNTY OF FRANKLIN, CITY OF COLUMBUS, BEING IN THE EAST HALF OF SECTION 36, TOWNSHIP 4, RANGE 22, CONGRESS LANDS.


BASIS OF BEARINGS: A GPS SURVEY OF FRANKLIN COUNTY MONUMENTS FCGS 9930 AND FCGS 9927 PERFORMED BY THE FRANKLIN COUNTY ENGINEER'S OFFICE IN 1991, AND IS BASED UPON THE NAD83 OHIO STATE PLANE COORDINATE SYSTEM, SOUTH ZONE, AND DETERMINES THE CENTERLINE OF SHOOK ROAD TO BE NORTH 03°37'38" EAST.

0-26-E  
HAMILTON Twp.

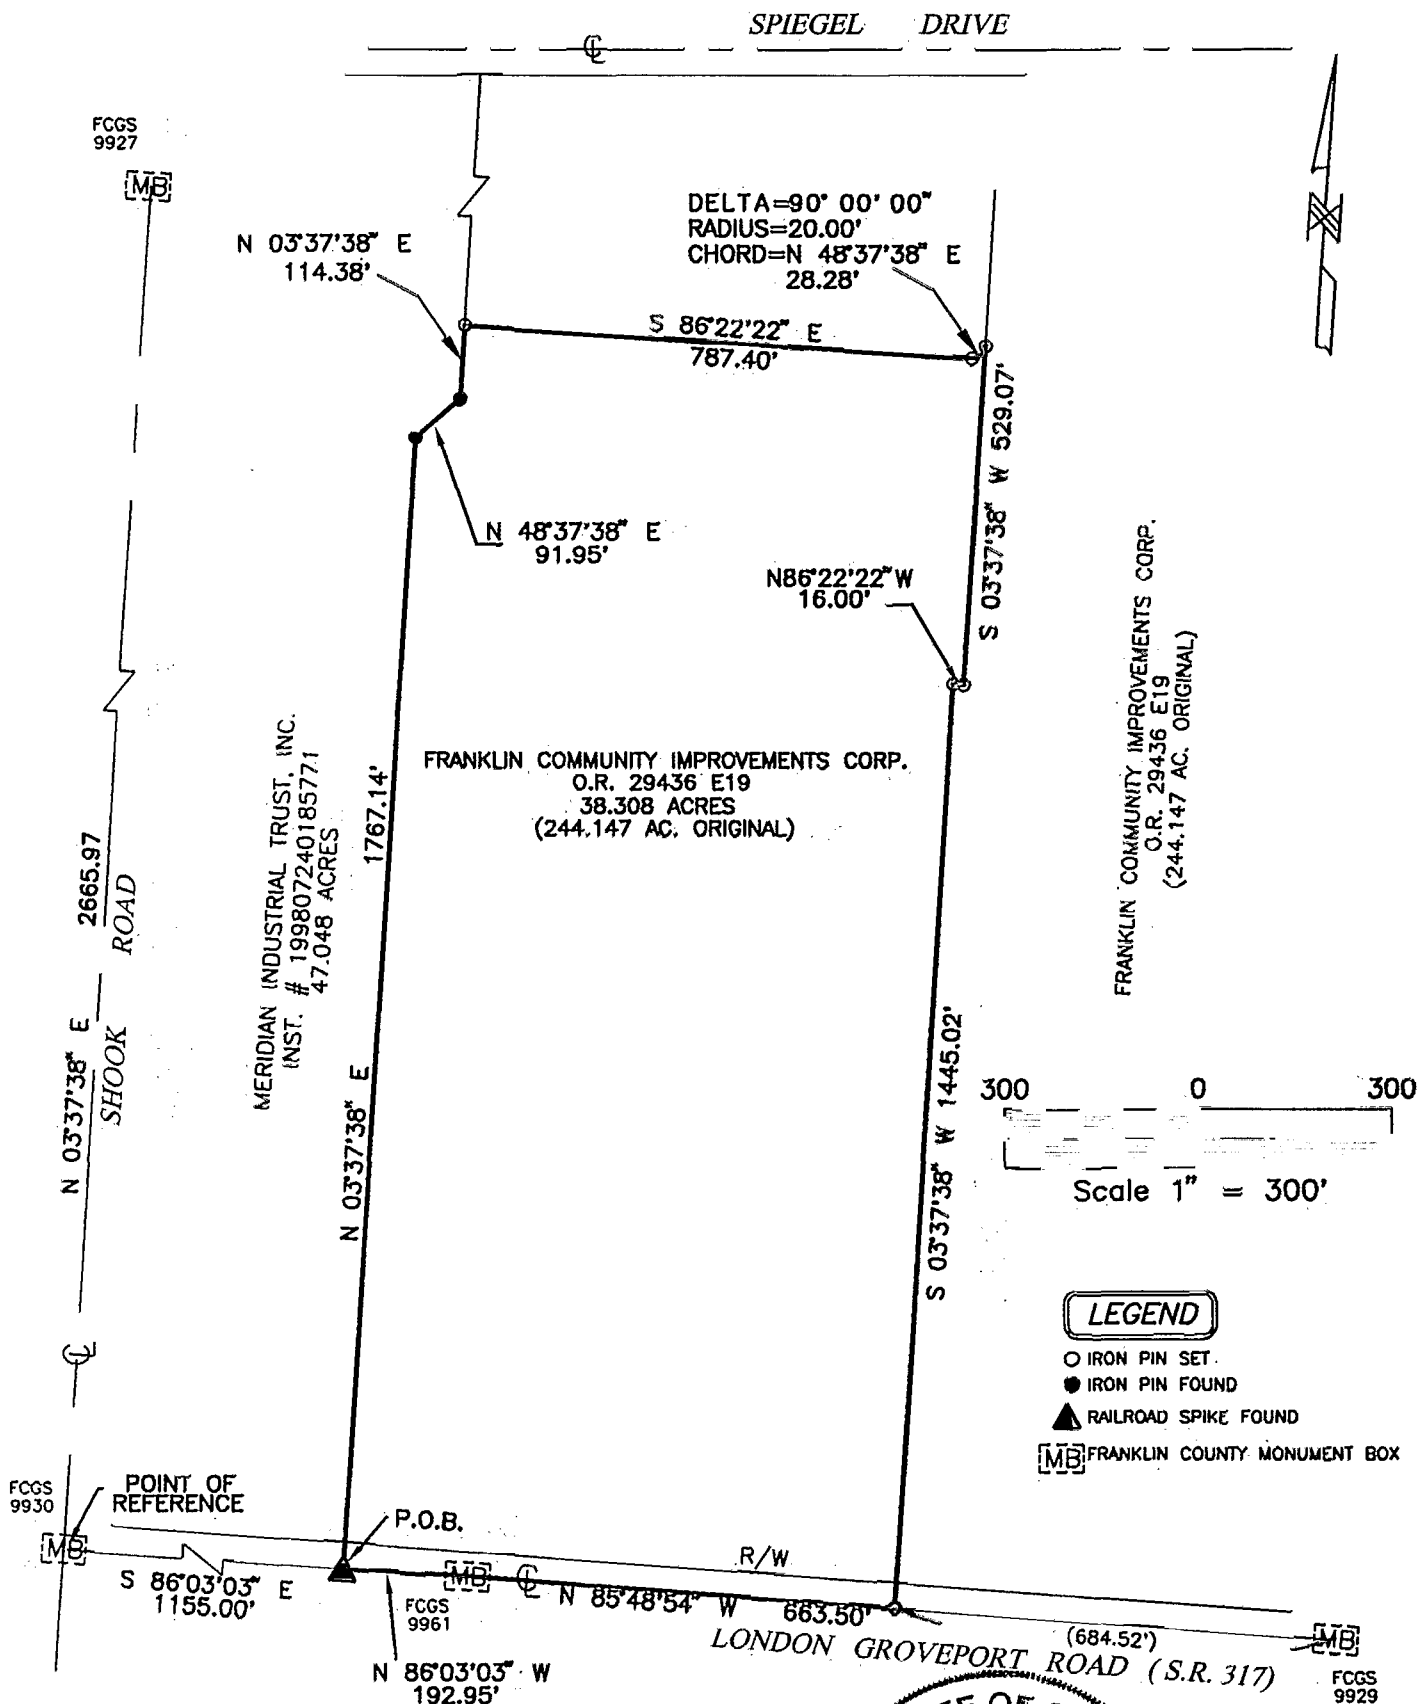

DRAWN BY: N.G.G.
DATE: 12-13-99
DWG. NO.: 1130
APPROVED BY: D.R.H.

*Douglas R. Hock*  
DOUGLAS R. HOCK  
P.S. NO. 7661

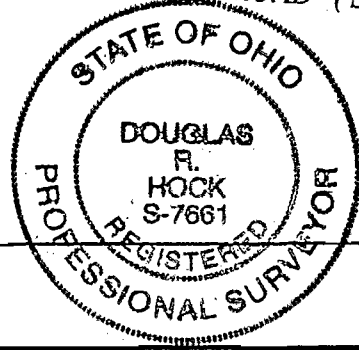

1-21-99  
DATE:

84356650  
84356675