

18485 5725

HOY SURVEYING SERVICES, INC.

6624.93

ORDER NO.

ELAND AVENUE

COLUMBUS, OHIO 43231

PHONE 614-895-1922

FAX 614-895-1940

CERTIFIED TO KATHY MENDENHALL



COUNTY OF FRANKLIN

LENDER _____

P.B. 7 PG. 440 OR. _____ PG. _____

BUYER _____ DATE 8.30.93

SCALE 1" = 20' DRN. D.E.S. CH. 345.

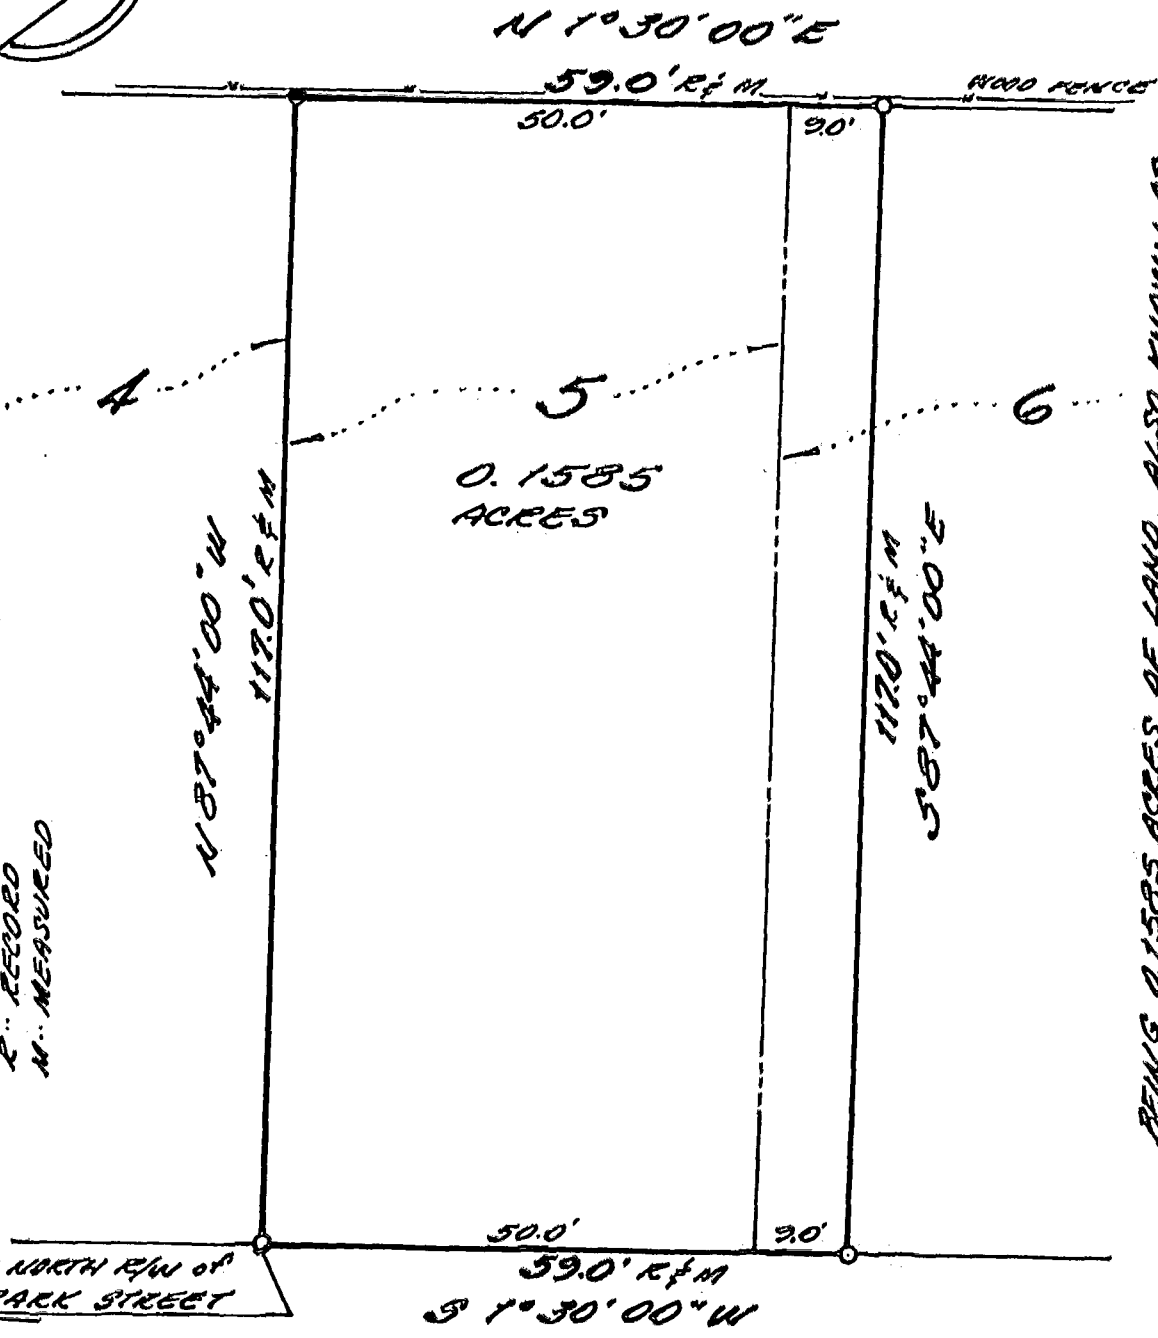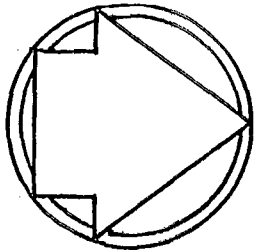

LEGEND

- FOUND $\frac{3}{4}$ " OPEN IRON PIPE
- SET $\frac{3}{4}$ " IRON PIPE WITH PLUG (NOY. No. 7313)
- R... RECORDED
- M... MEASURED

BEING 0.1585 ACRES OF LAND, ALSO KNOWN AS BEING LOT NO. 5 & 90' OFF SOUTH SIDE LOT NO. 6 C.W. WATSON'S SUBDIVISION WESTERVILLE, FRANKLIN CO., OHIO PLAT BOOK 7, PAGE 440

SUMMIT STREET 50'

The bearing system used in the foregoing description is based on the westerly right-of-way line of said Summit Street being $S 01^{\circ} 30' 00'' W$.

We hereby certify that the foregoing BOUNDARY SURVEY was prepared in accordance with Chapter 4733-37, Ohio Administrative Code, pursuant to Chapter 119 of the Ohio Revised Code.

By Stevli J. Hoy
 Registered Surveyor No. 7313

L-1