

18485 7725

MYERS SURVEYING CO.

2740 East Main Street, Columbus 9 (Bexley), Ohio


BEING PART OF THE WEST PART OF THE JOHNSON, OR OTTERBEIN UNIVERSITY FARM, WESTERVILLE, OHIO

FOR
TITLE INS. CO. OF MINNESOTA
AND / OR
NATIONAL HOMES ACCEPTANCE CORP. M-6

P.B. Page
Scale 1" = 20'

Franklin Co. Rec. Office
9-30-74

REC. 10-5-74

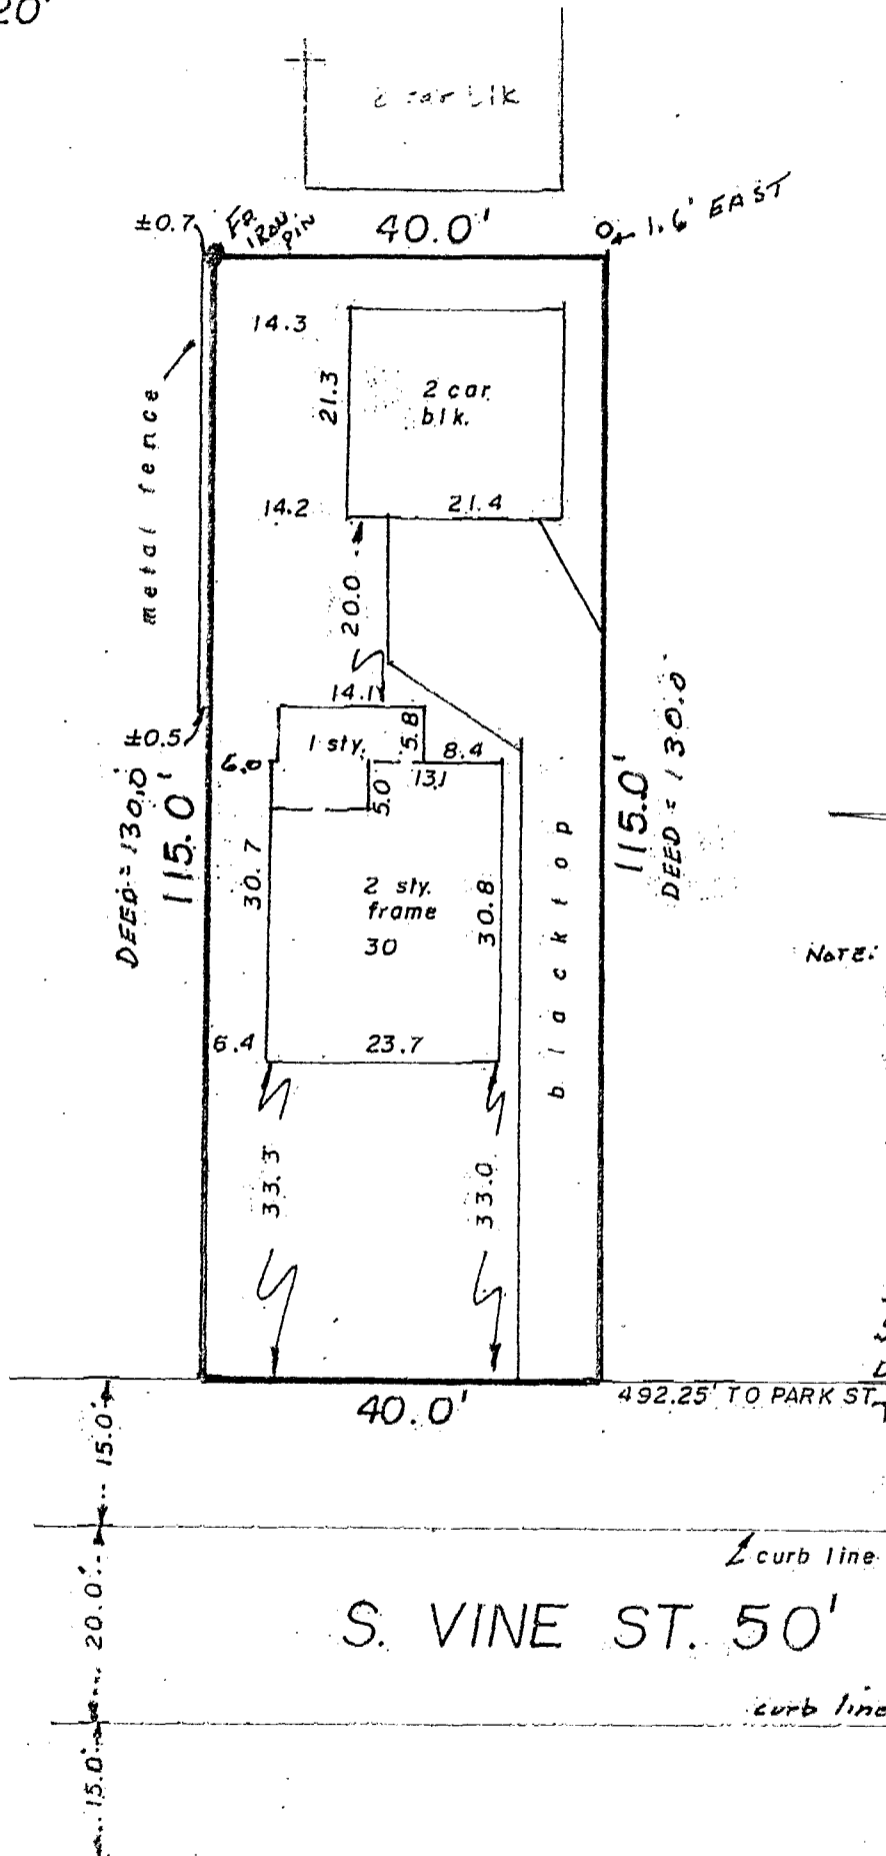

NOTE: IN THE OPINION OF THE UNDERSIGNED, BASED ON SURVEY MONUMENTS AND OCCUPIED LINES, AND A OTHER DEEDS IN THE SUBJECT BLOCK THAT CALLED FOR DEPTH MEASUREMENTS TO BEGIN AT THE CURB I BELIEVE THAT THE SUBJECT DESCRIPTION DEPTH WAS INTENDED TO INCLUDE THE 15 FEET OF RIGHT OF WAY LYING BETWEEN THE CURB AND PROPERTY LINE

[Signature]

S. VINE ST. 50'

We hereby certify that the foregoing plat was prepared from an actual survey of the premises. No side line of principal building is less than dimension shown. Iron pins not set unless indicated thus -0-. For Mortgage Loan & Title Insurance purposes only.

MYERS SURVEYING CO.
[Signature]
Registered Surveyor

KOON