



16 1/2' ALLEY

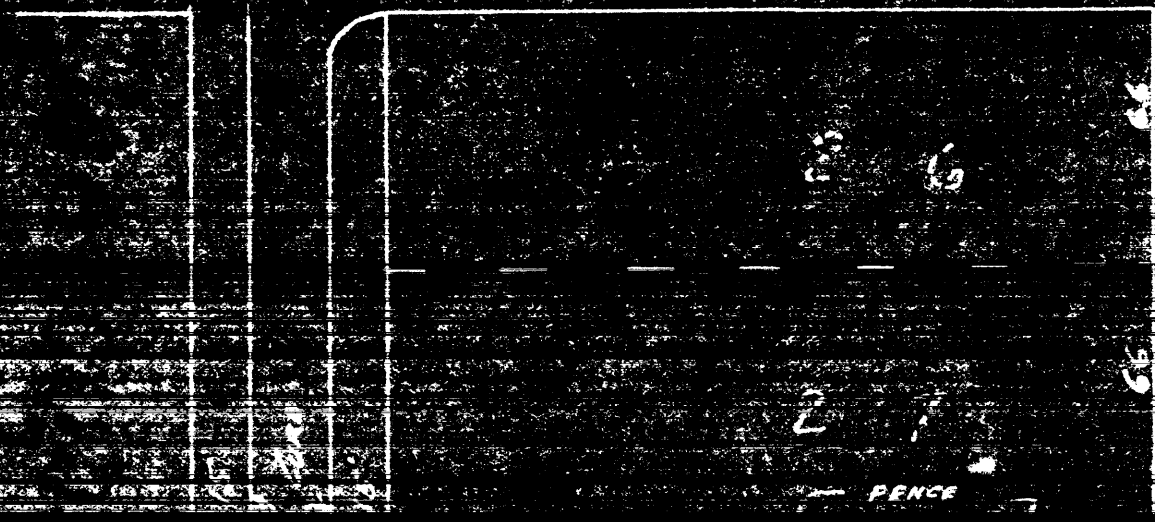

66 FT ALLEY

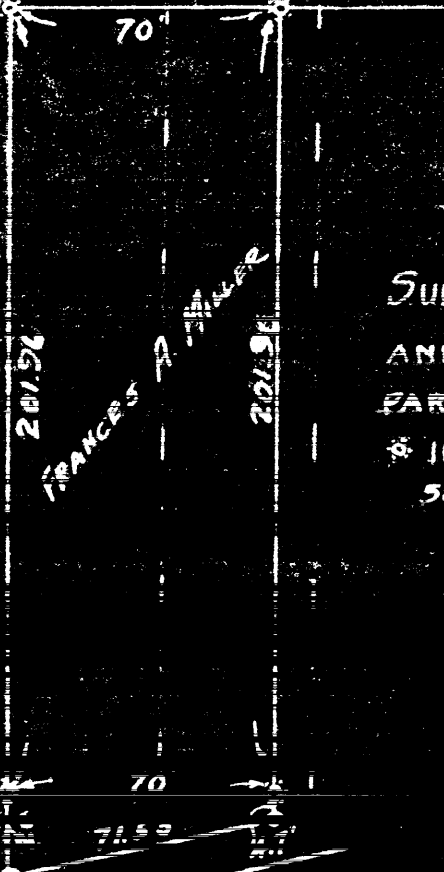

SURVEY OF EAST PART OF LOT 28 OF "SLAUGHTER AND TABLER'S ADDN." WESTERVILLE, O. ALSO A PART OF HANBY PARK. O = IRON PIPE SET.
 * IRON PIPE SET BY PROF. DURANT, AUG. 9-10, 1940.
 SCALE 1" = 50'

REGISTERED SURVEYOR, Col. O.

