


JOHN FRANK BUSSE & MARTHA JANE BUSSE

0-1-B

CITY OF WESTERVILLE, COUNTY OF FRANKLIN, STATE OF OHIO
 RANGE 17 W., TOWNSHIP 2 N., QUARTER TOWNSHIP 2, U.S.M.L.

Parcel Number
 080-2486

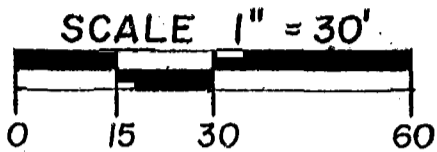

JOHN FRANK BUSSE &
 MARTHA JANE BUSSE
 O.R. 6504 P. G-18
 O.R. 15762 P. E-18

Parcel Number
 080-1451

LEGEND

- IRON PIN SET
- IRON PIN FOUND

278.69'
 N 44° 01' 44" E
 0.448 ACRES

# 2486	8.4	Sq. Ft.
# 1451	19,491.4	Sq. Ft.
Total	19,499.8	Sq. Ft.

200.00'
 S 0° 22' 27" E

S 89° 53' 21" W
 195.00'
 136.03'


LOT NO. 66

COOK DEVELOPMENT, INC.
 O.R. 8844 P. J-09

AMENDED PLAT OF
 COLLEGE KNOLLS PHASE 2
 P.B. 71 P. 41

Charles J. Destefani
 CHARLES J. DESTEFANI

PROFESSIONAL SURVEYOR NO. 5666

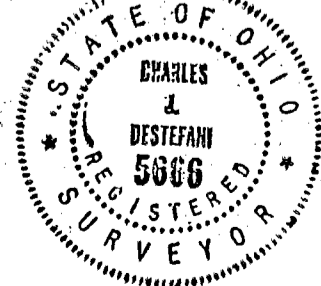

Basis of bearings is
 Amended Plat of College
 Knolls, Phase 2
 (P.B. 71 P. 41)

DRAWN BY M.A.E.
 DATE 5-21-1991
 REV. DATE 6-9-1992

PREPARED BY
 CITY OF WESTERVILLE
 ENGINEERING DEPARTMENT

85107752

copy of...

0-1-B