


O 1 B

12.86 ac.
CITY OF WESTERVILLE
O-1-B

Billy J. & Phyllis Letner
OR. 6349 F-18,19

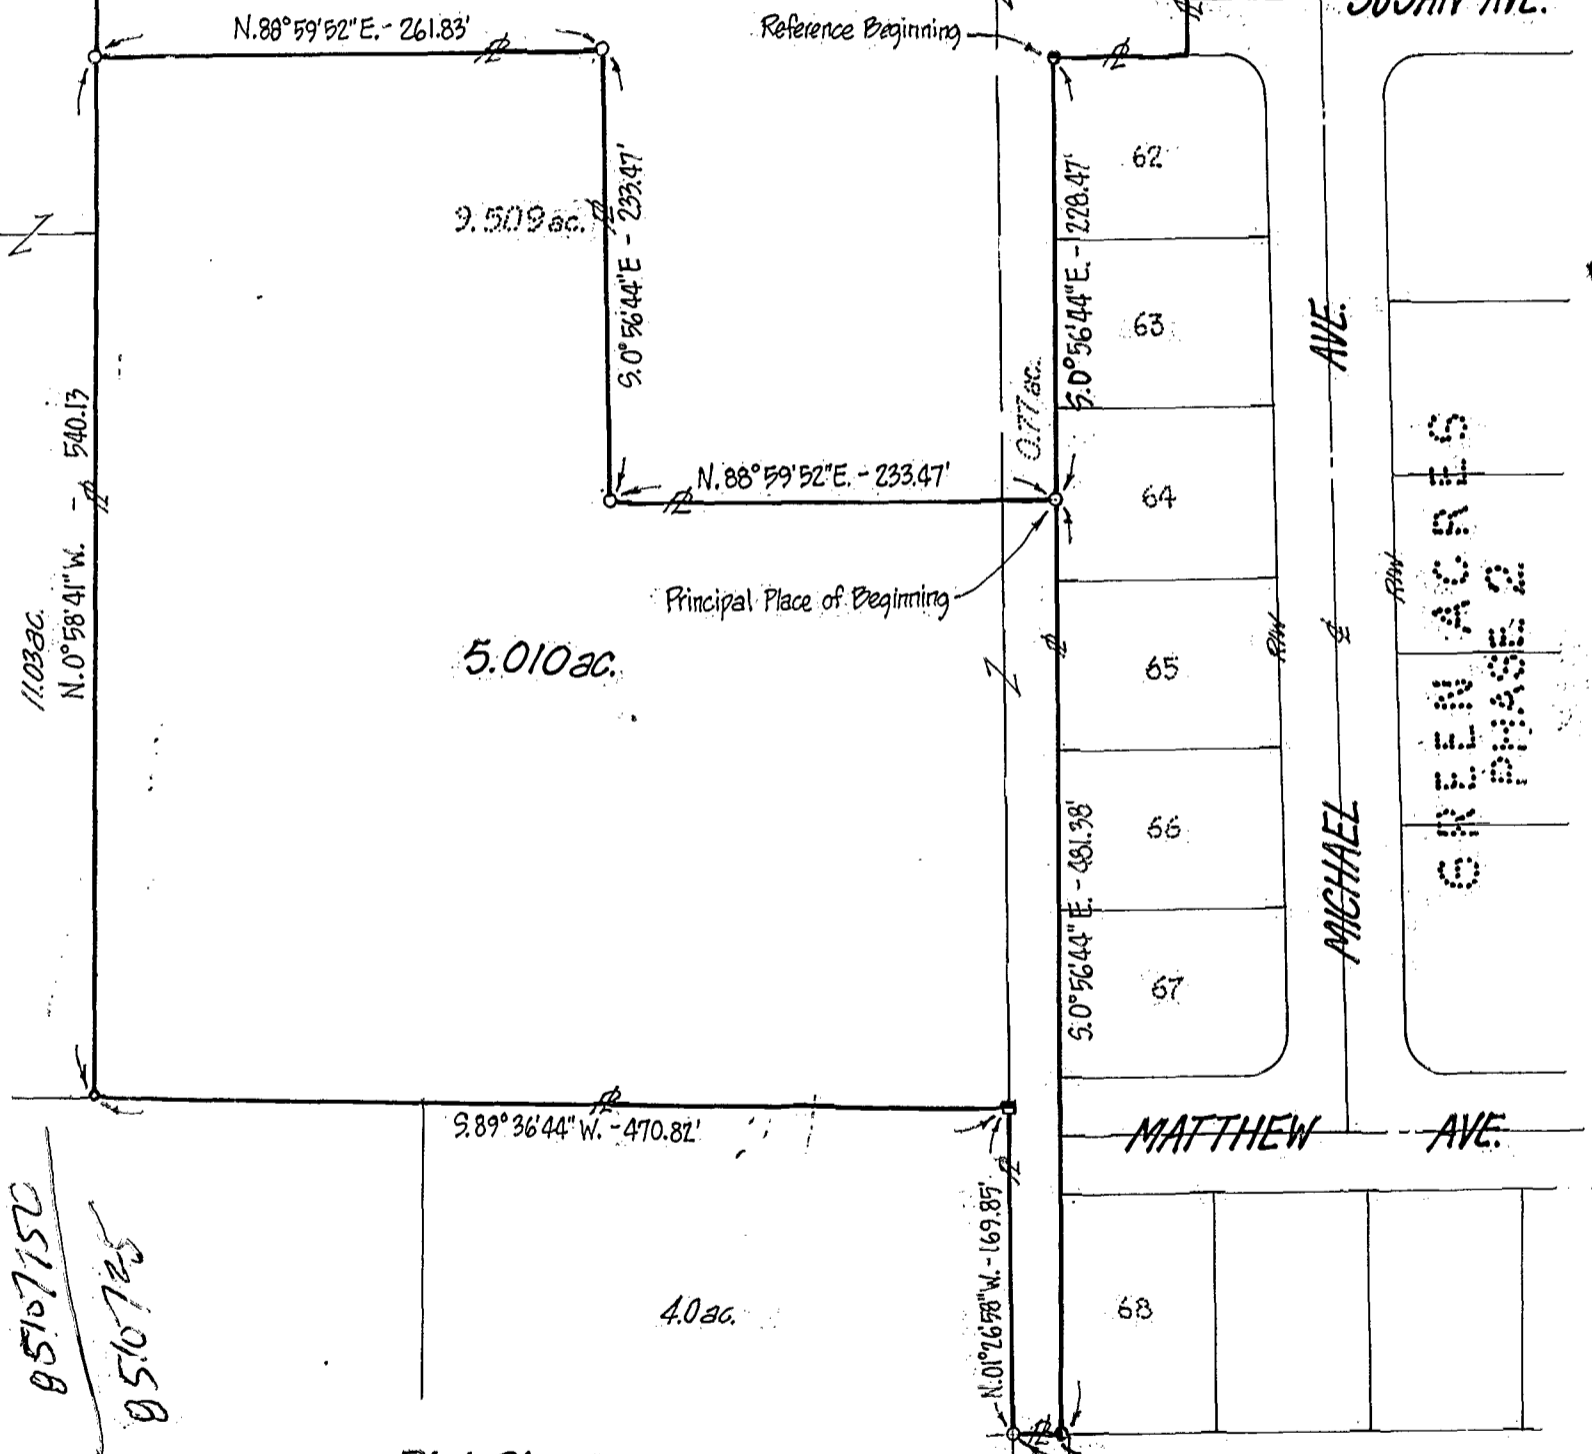

11.03 ac.
N. 0° 58' 41\" W. - 540.13'

N. 88° 59' 52\" E. - 261.83'

9.509 ac.

S. 0° 56' 44\" E. - 233.47'

N. 88° 59' 52\" E. - 233.47'

5.010 ac.

Principal Place of Beginning

Reference Beginning

S. 0° 56' 44\" E. - 228.47'

S. 0° 56' 44\" E. - 481.98'

N. 01° 26' 58\" W. - 169.85'

S. 89° 36' 44\" W. - 470.82'

4.0 ac.

S. 88° 33' 02\" W. - 22.70'

05107150
0510725

SUSAN AVE.

AVE.

MICHAEL

MATTHEW AVE.

68
67
66
65
64
63
62
61
60
59

Plat Showing
5.010 acre tract
Located in
Section 2, Township 2,
Range 17, U.S. Military Lands
Blendon Twp., Franklin Co., Ohio

SURVEY BY
WALTER DODSON
REG. NO. 6446



1"=100'

- 5/8" x 30" Re-bar w/1.0 cap. Set
- Iron Pin Found
- Stone Found
- P.K. Found

COLLEGE

STREET