

Myers Surveying Company, Inc.

2740 East Main Street, Columbus 43209 (Bexley), Ohio
614-235-8677 FAX: 614-235-4559

A Boundary Survey prepared for and certified to:
Chicago Title Insurance Company and/or BancOhio Mortgage Co.


Legal Description: Being a 1.594 Acre tract, part of Section 1, Township 2, Range 17, United States Military Lands, Blendon Township, Franklin County, Ohio.

Applicant: Alvarez

Posted Address: 4720 E. Walnut Street, Blendon Twp., Ohio

F.E.M.A. Flood Zone Designation: Flood Zone "C" as per F.I.R.M. 390167 0055B

Apparent Encroachments: 1) Blacktop Over Property Line. 2) Overhead Wires Crossing Property. 3) Eaves and Gutters Over Property Line.

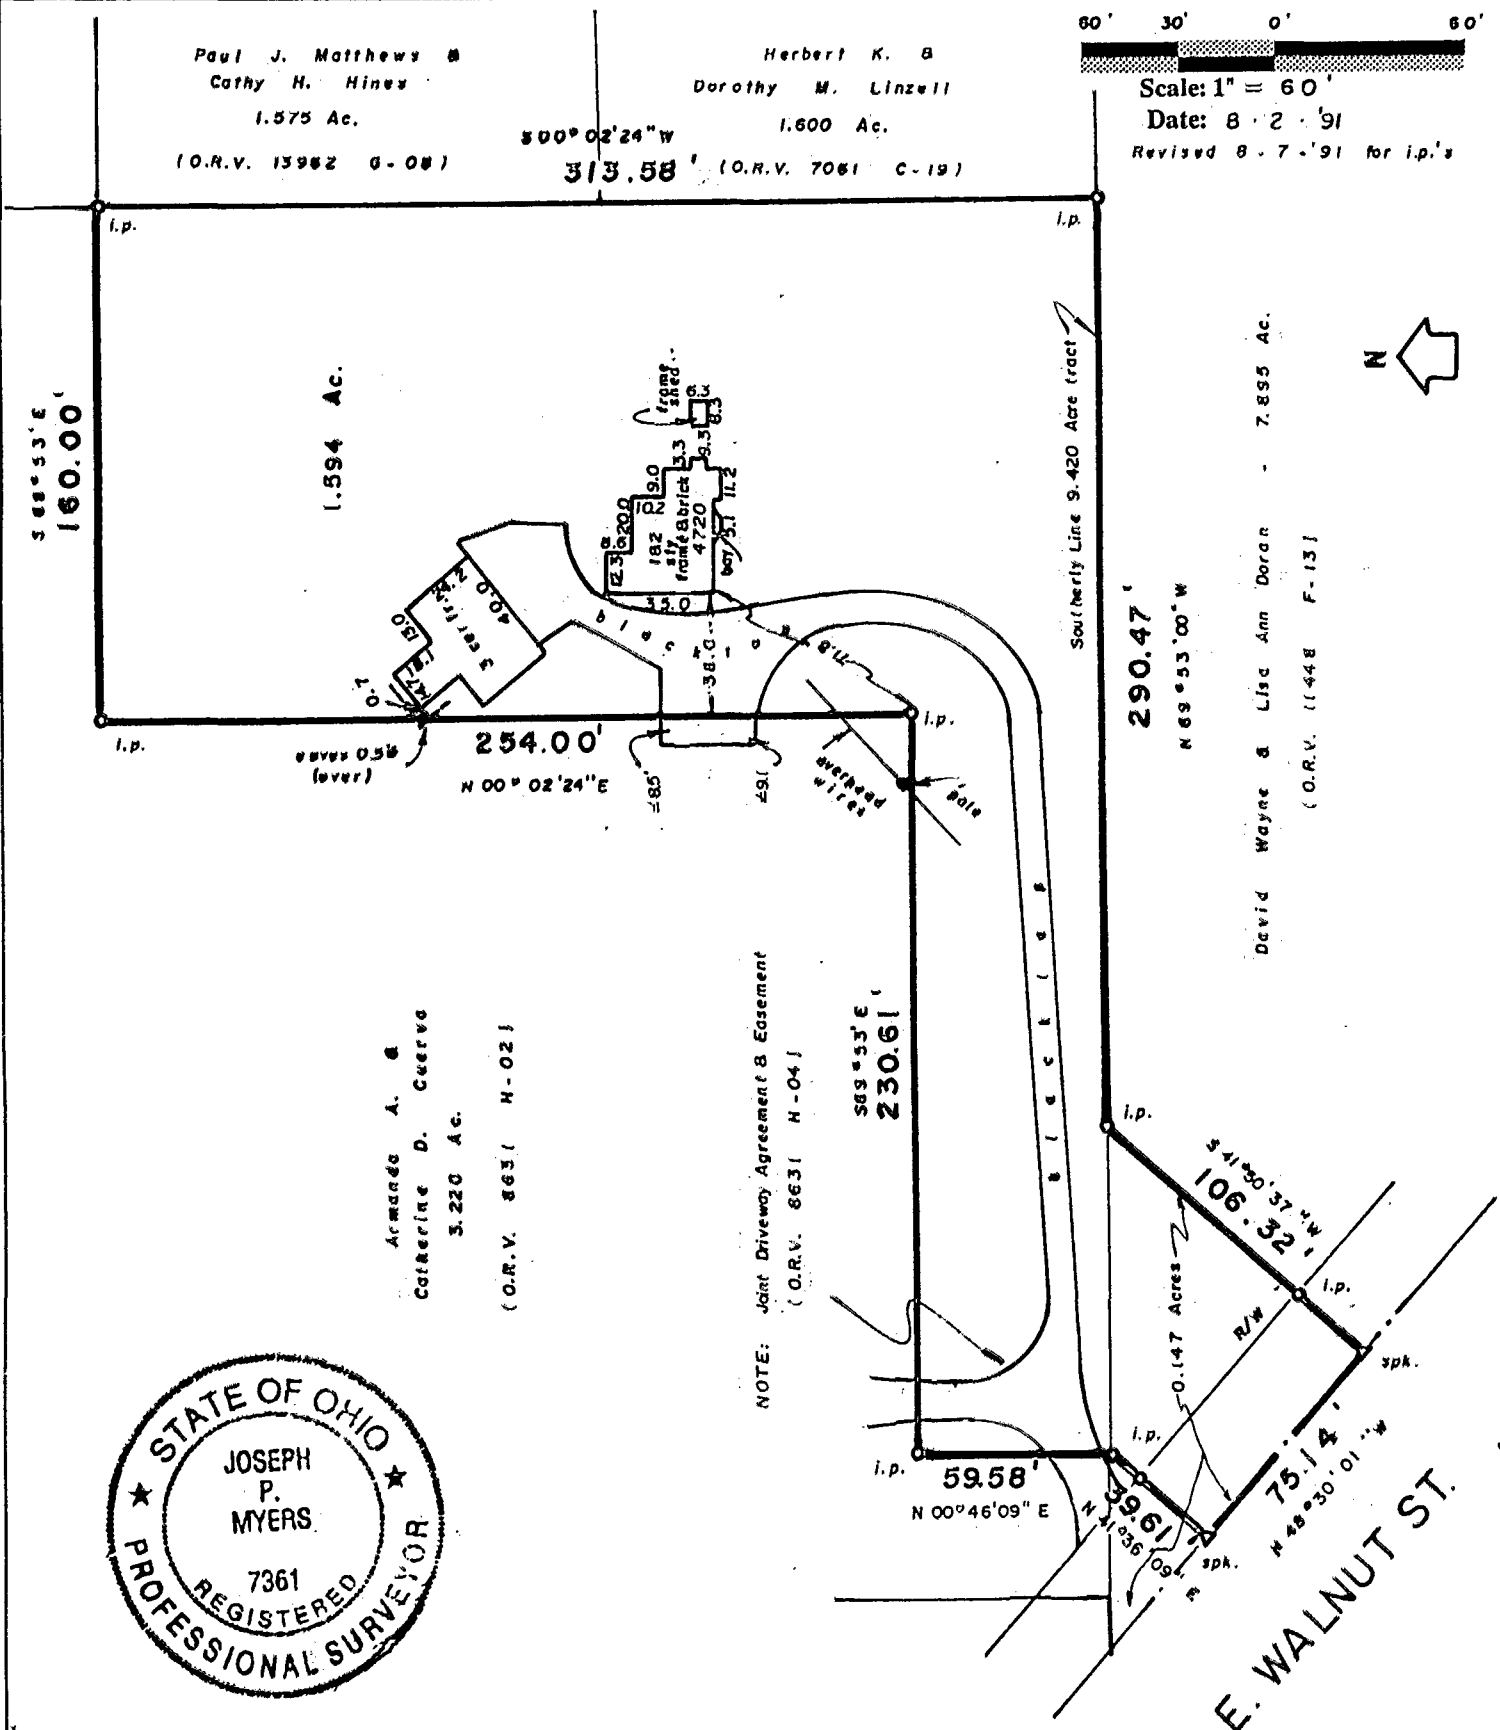

NOTE: Joint Driveway Agreement & Easement (O.R.V. 8631 H-04)

We hereby certify that the foregoing Boundary Survey was prepared from actual field measurements in accordance with Chapter 4733-37 Ohio Administrative Code. Iron pins set are 30"x1" O.D. with an orange plastic plug inscribed "P.S. 6579", unless otherwise noted. Basis of bearing is Southerly line of the 9.420 Acres

Myers Surveying Co., Inc.
By Joseph P. Myers
Professional Surveyor

Myers Order No. - 29-91-07-31	Rec. LE	Field gh	DWG mz	Ltr.	Ck. y
-------------------------------	---------	----------	--------	------	-------

196517700

Blendon Twp

0-2-B