PART OF THE SOUTHWEST QUARTER OF SECTION 4

T-2, R-16, PLAIN TOWNSHIP

70-27914 FRANKLIN COUNTY, OHIO

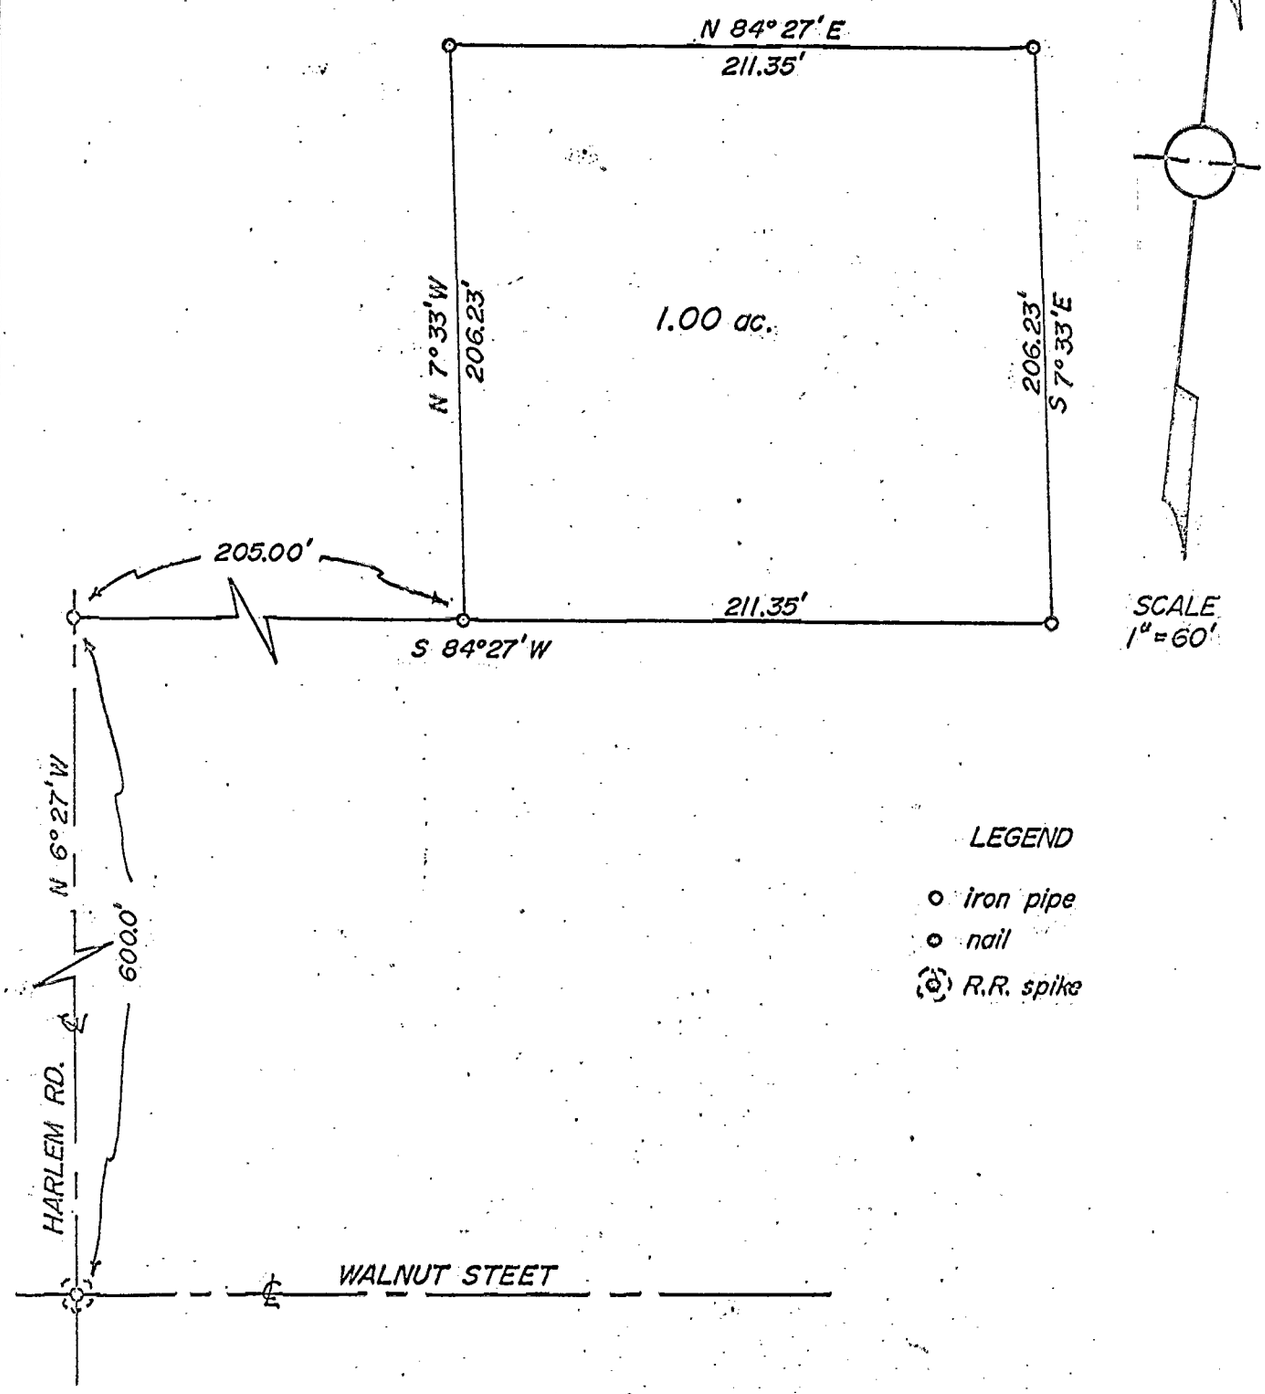

I, the undersigned, hereby certify that this survey is true and correct to the best of my knowledge.

Kenneth O. Jenkins S-5458

DATE July 20, 1970

18735 7100

4880 VOL 1100 PG 1 CHRISTE HARLEM ROAD 0132 0003