

# EVANS MECHWART HAMBLETON & TILTON

CIVIL ENGINEERS — SURVEYORS  
GAHANNA, OHIO


74-A

## SURVEY OF ACREAGE PARCELS SEC. 1, TWP. 2, RANGE 16, U.S.M. LANDS PLAIN TWP, FRANKLIN CO., OHIO

SCALE 1" = 200'  
o = Iron Pin

DEED BOOK 1322, PAGE 499  
PLAT BOOK \_\_\_\_\_, PAGE \_\_\_\_\_

0280  
120  
063  
091  
S  
BEVELHEIMER ROAD  
1000  
074  
003

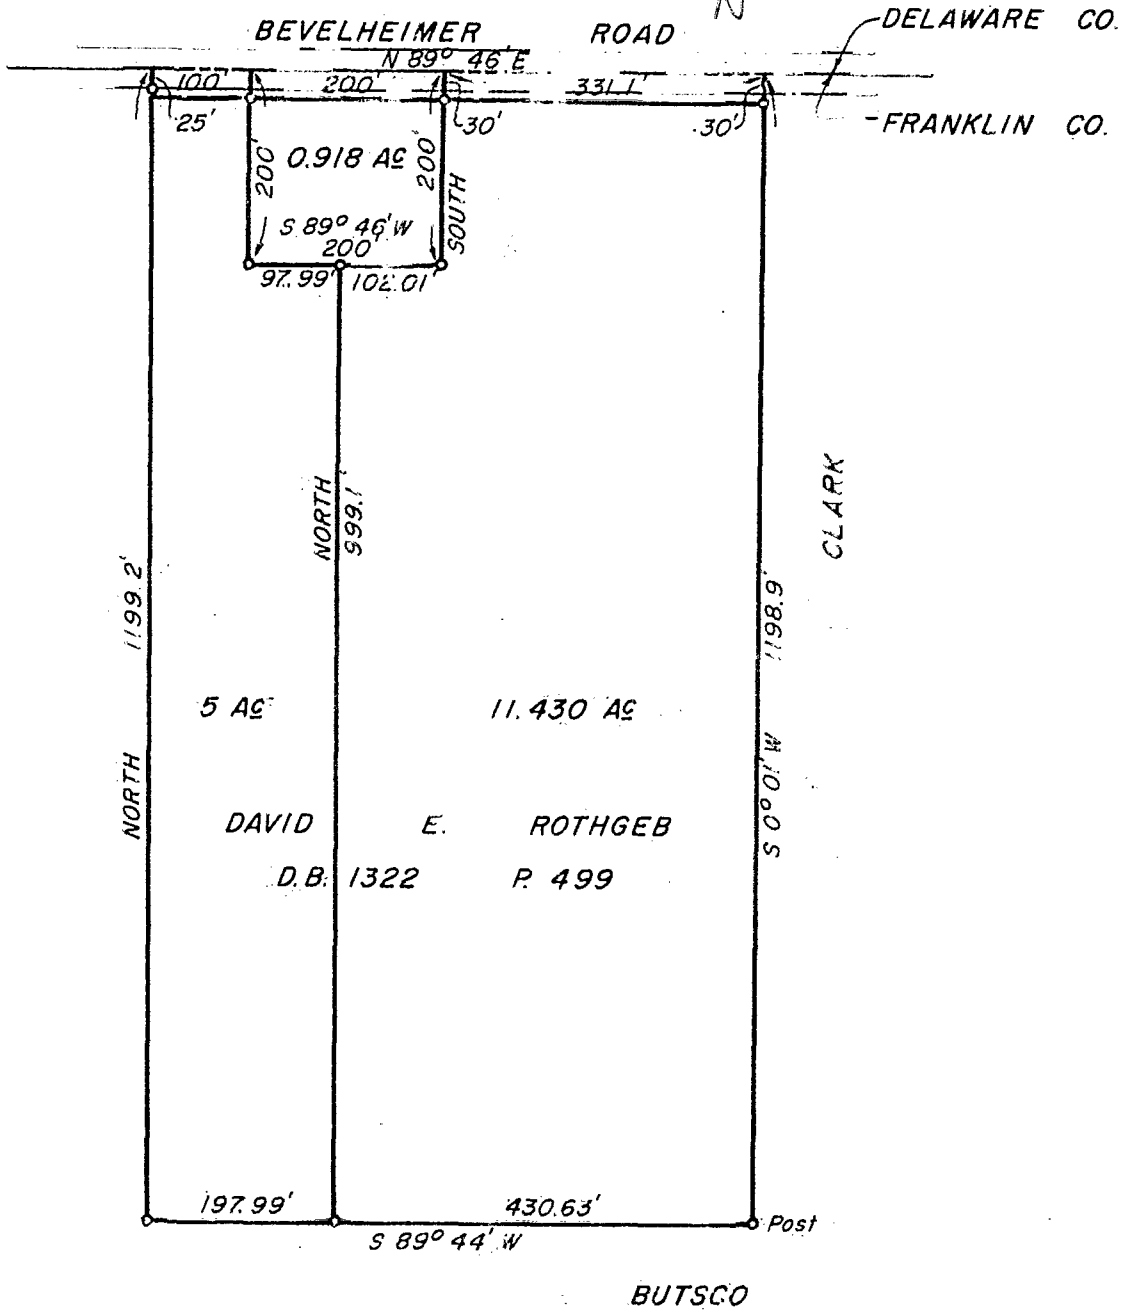

We hereby certify that the foregoing plat was prepared from an actual survey of the premises and shows the location of the boundaries.

18835 1750  
18835 1725

EVANS MECHWART HAMBLETON & TILTON

BY *[Signature]*  
Registered Surveyor # 483