

R. D. WILLIS & ASSOCIATES

ENGINEERING AND SURVEYING

6784 LAIRD AVENUE

REYNOLDSBURG, OHIO

TELEPHONE 866-6000

0-74-B

003

0742

7000

RCAD

HOOPER









A SURVEY OF A 5.001 ACRE TRACT OUT OF A 19.746 ACRE TRACT IN SECTION 1, QUARTER TOWNSHIP 1, TOWNSHIP 2, RANGE 16, UNITED STATES MILITARY LANDS.

Fred Miller
44.949 Ac.

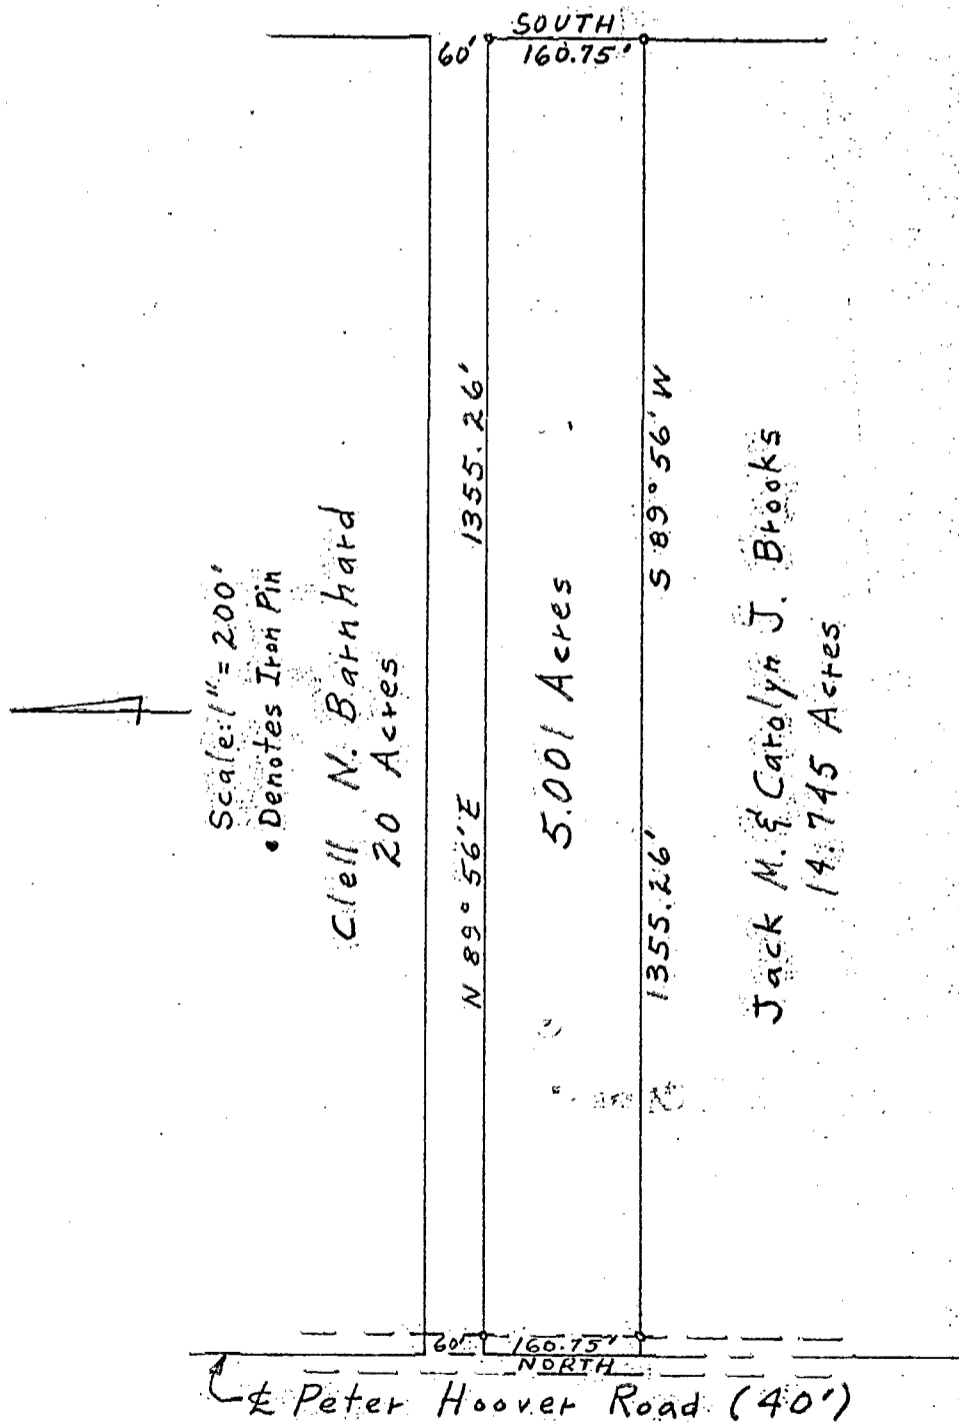

We hereby certify that the foregoing plat was prepared from an actual survey of the premises and shows the location of the boundaries.

SCALE: 1" =
ISSUED _____

Roger D. Willis

ROGER D. WILLIS
REGISTERED SURVEYOR #5365