EXHIBIT

SITUATED IN THE STATE OF OHIO, CITY OF WESTERVILLE
BEING 0.111 ACRE TRACT WITHIN THAT 6.661 ACRES TRACT
AS DESCRIBED ON ORV 3970F07.

IRON PINS SET CONSIST OF 0.5 O.D., 30 " LONG IRON PIPE
WITH A PLASTIC CAP INSCRIBED "A TO Z SURVEY"

BEARING HEREIN ARE BASED ON THOSE OF THE REFERENCED DEED
OR AS MARKED (*) WITHIN.

THIS EXHIBIT WAS PREPARED BASED ON AN ACTUAL FIELD SURVEY
OF THE PREMISSES, PERFORMED IN JUNE 1998.

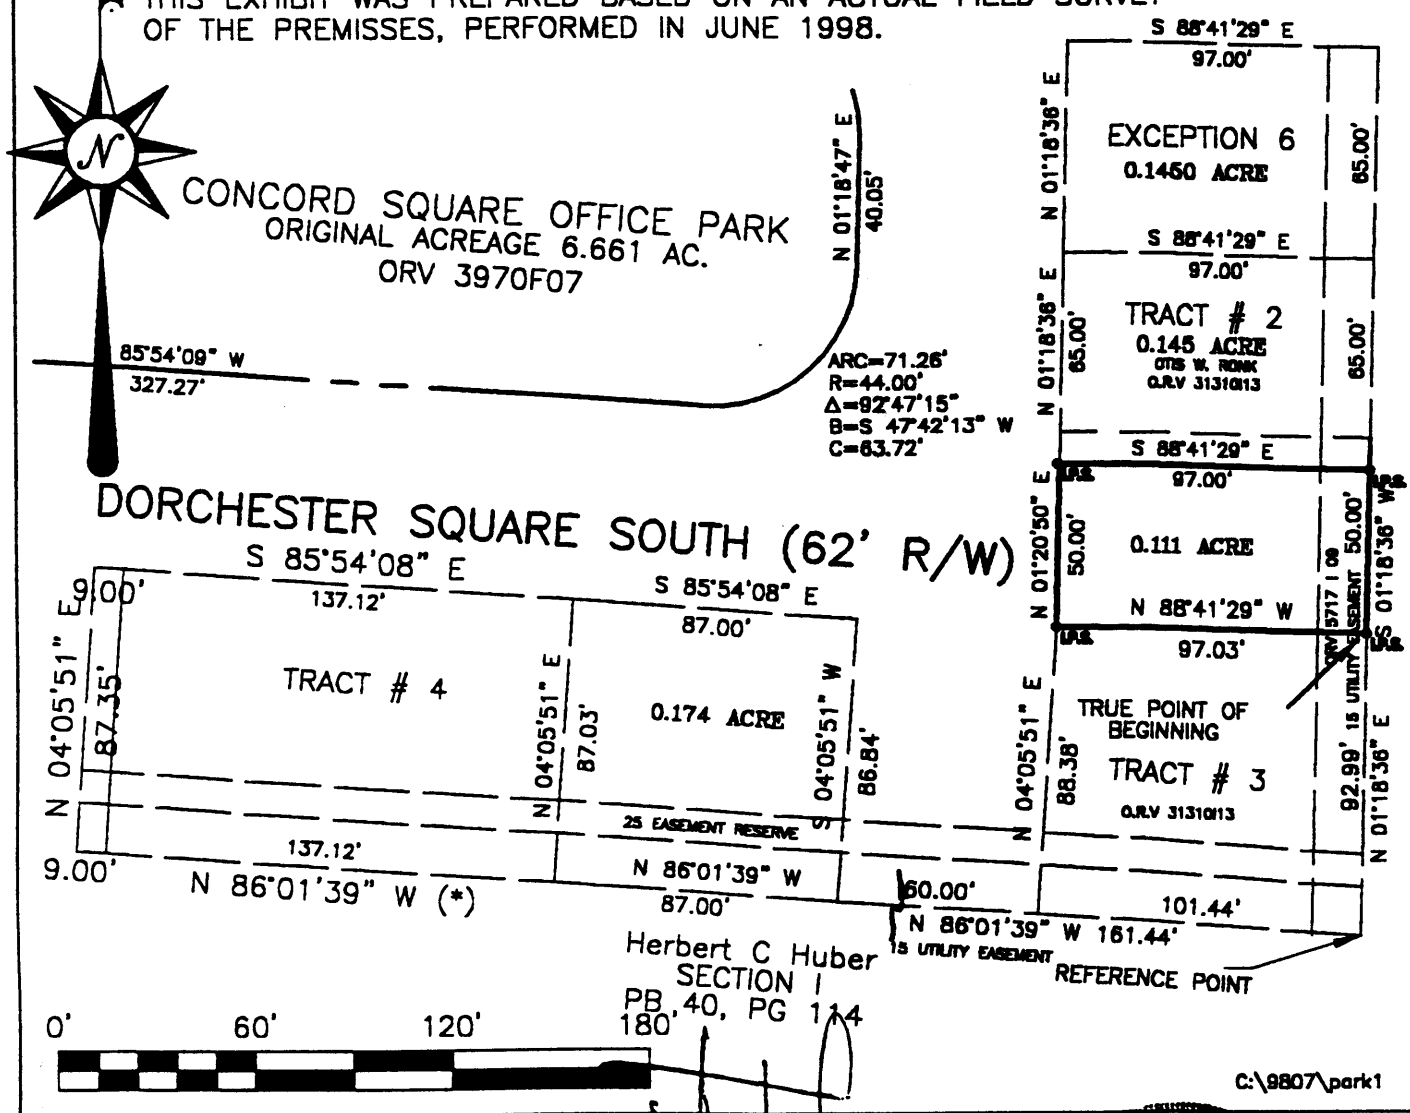

REGISTERED PROFESSIONAL SURVEYOR JOSUE TIRADO No. S7254 DATE 9/28/98

PROJECT CONCORD SQUARE	JOB NO. 9807	
SUBJECT SPLIT	REVISION DATE	
SURVEYED BY JOSUE' DRAWN BY JOSUE'	CHECKED	

A TO Z
SURVEYING & INFORMATION CO.
THE SOLUTION TO YOUR SURVEYING NEEDS

STATE OF OHIO JOSUE TIRADO REGISTERED PROFESSIONAL SURVEYOR

84 857650