


0-1-D

SURVEY FOR  
GEORGE MALICK  
RANGE 17, TOWNSHIP 2, SECTION 2, LOT 4, USML,  
CITY OF WESTERVILLE, FRANKLIN COUNTY, OHIO

Scale 1" = 100' Date 3-22-1989 P.B. P. D.V. 2553 P. D-15 Lot No.

BEARING BASIS FROM  
LEXINGTON PARK NO. 2  
P.B. 38 P. 107

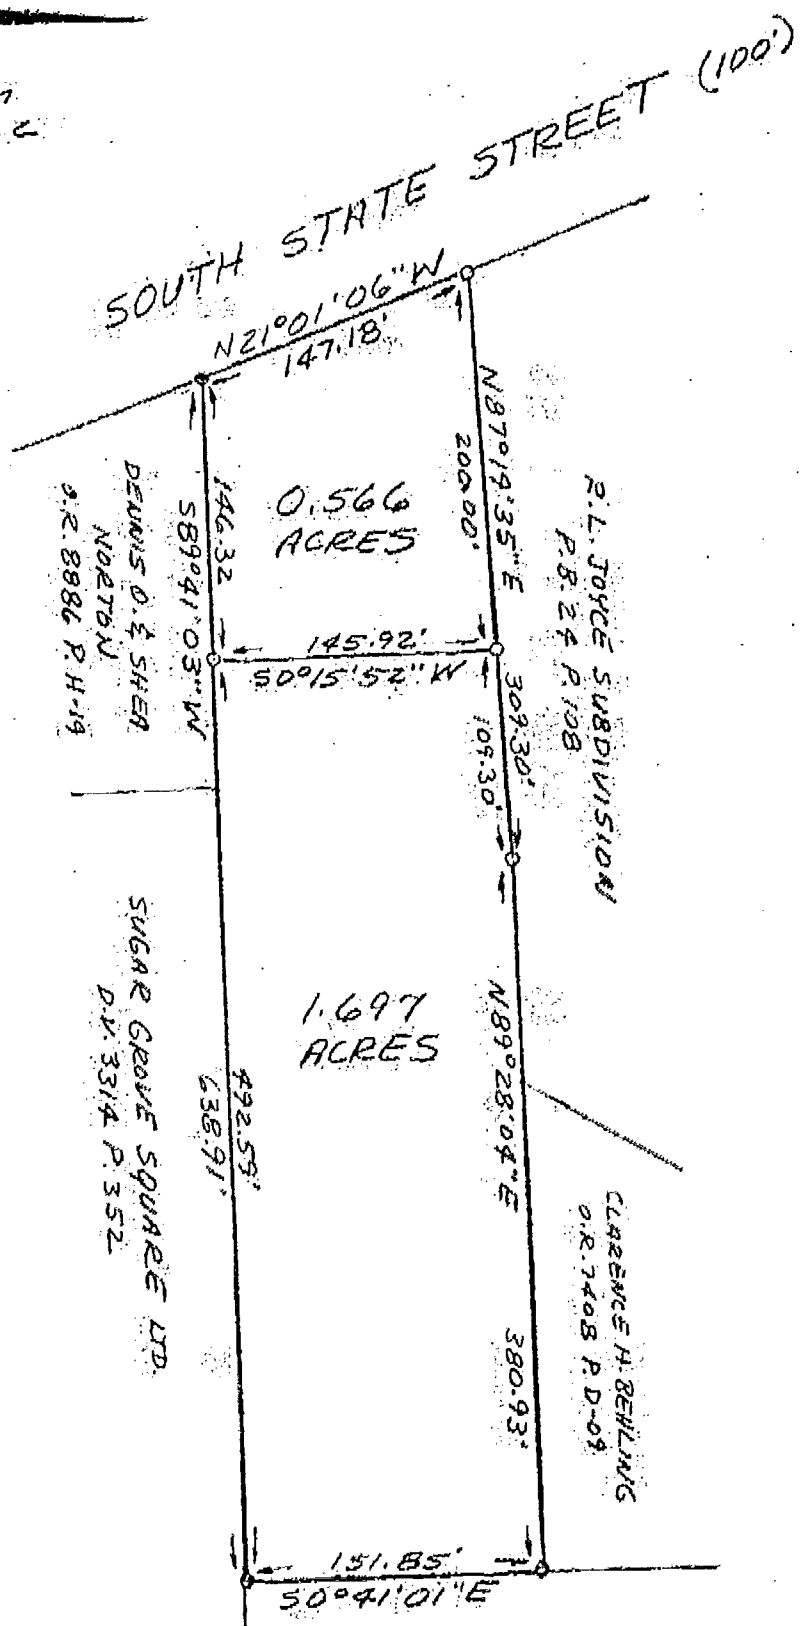

84857675

LEGEND

- IRON PIPE FOUND
- 3/4" X 30" IRON PIPE SET

LEXINGTON PARK NO. 2  
P.B. 38 P. 107



I hereby certify that the foregoing drawing was prepared from an actual survey of the premises.

Drawn by S.W.V.

*Samuel W. Vance*  
Registered Surveyor No. 6553

VANCE SURVEYING  
LAND SURVEYOR

9988 Tucker Road, Mount Vernon, Ohio 43050