BAUER, BOROWITZ & MERCHANT, INC.

CONSULTING ENGINEERS

2607½ NORTH HIGH STREET COLUMBUS, OHIO 43202

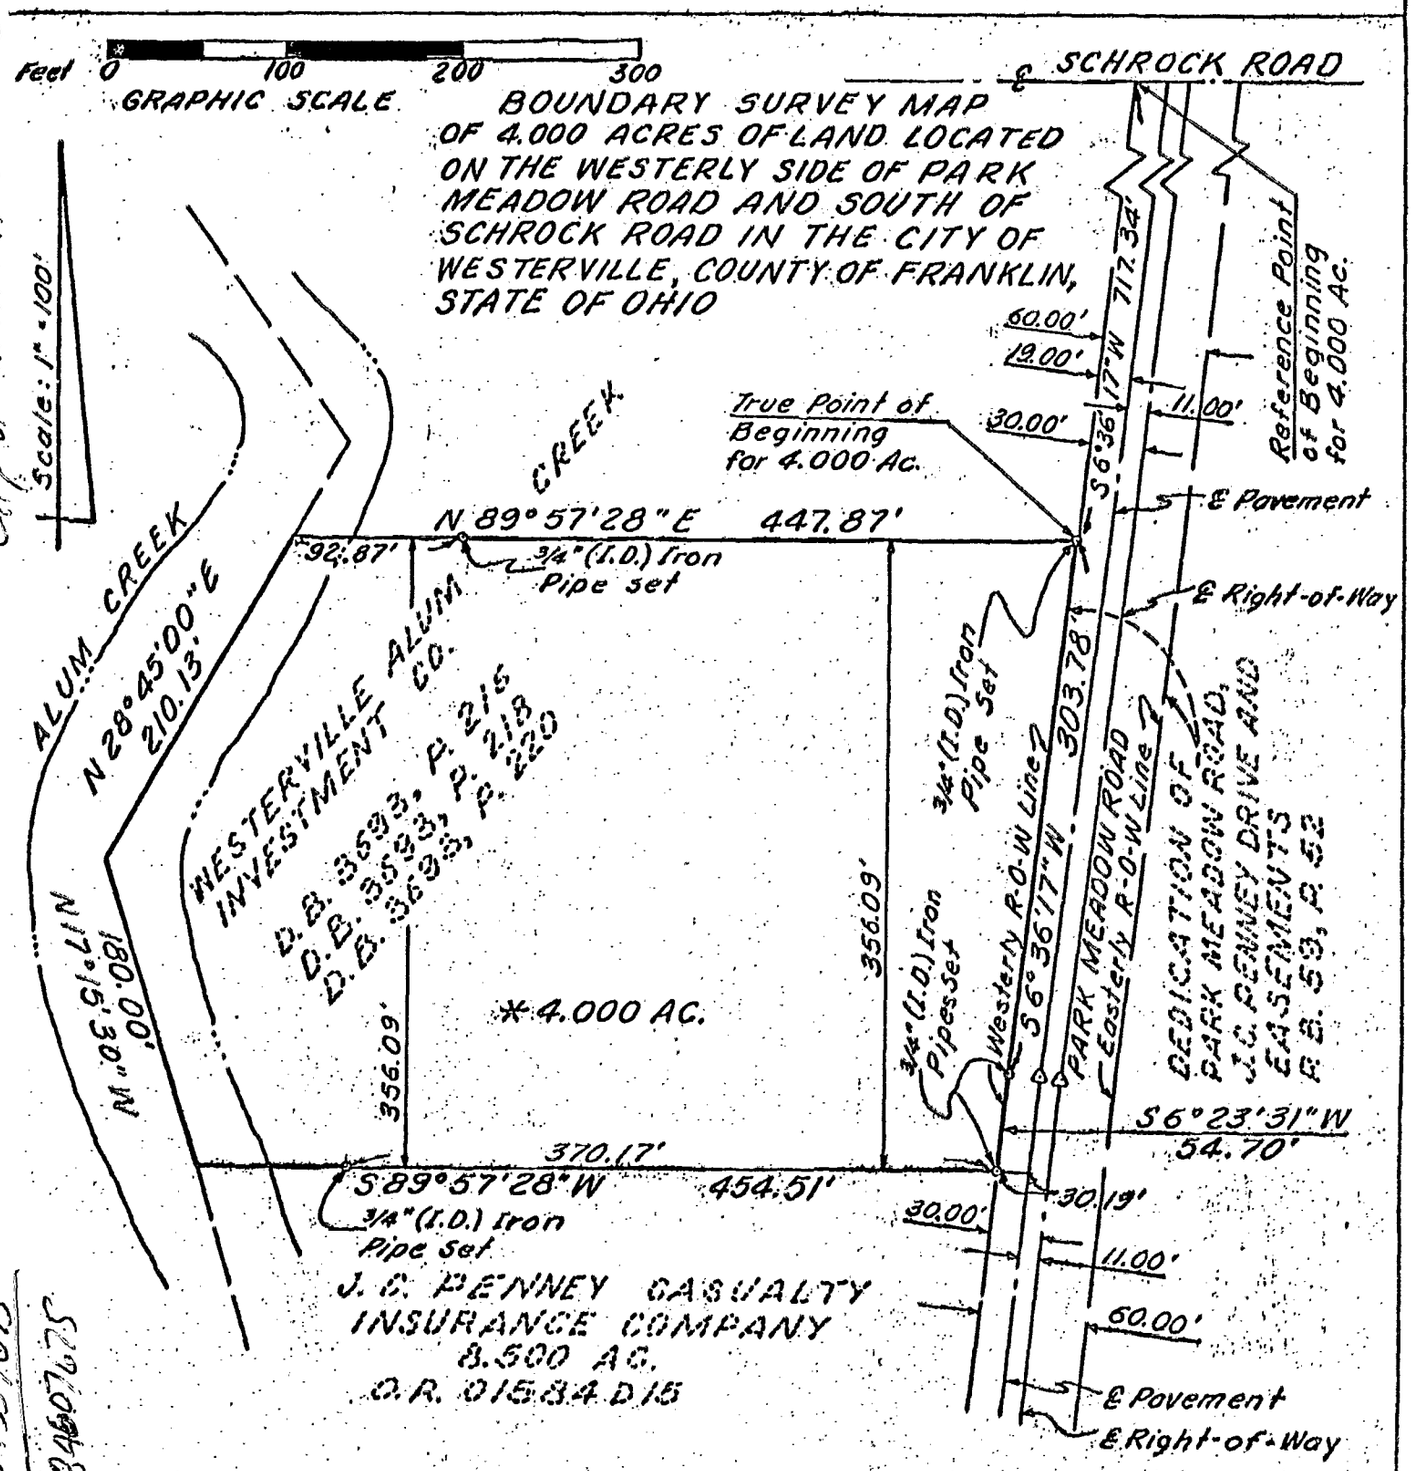

CITY OF WESTERVILLE

8435765

8460675

* Situated in the State of Ohio, County of Franklin, City of Westerville, being in Quarter Township 2, Township 2 North, Range 17 West, United States Military Lands, being 4.000 acres of land, more or less, said 4.000 acres being out of that tract of land conveyed to Westerville Alum Creek Investment Co. by deeds of record in Deed Book 3693, Page 216, Deed Book 3693, Page 218 and in Deed Book 3693, Page 220, all being of record in the Recorder's Office, Franklin County, Ohio.

We hereby certify that this map was prepared from information obtained from actual field surveys conducted by Bauer, Borowitz & Merchant, Inc. at various times during the period beginning on May 1, 1971 and ending on December , 1983, and that, to the best of our knowledge and belief, said map is correct. The survey markers indicated as set, were set by Bauer, Borowitz & Merchant, Inc. and the survey markers indicated as found were set by others. All of the survey markers noted on this map were in place on December 12, 1983.

The bearing shown on this map correspond to the bearings shown on the recorded plat of the Dedication of Park Meadow Road, J.C. Penny Drive and Easements.

BAUER, BOROWITZ & MERCHANT, INC.
CONSULTING ENGINEERS
December 13, 1983

By William W. Merchant
Registered Surveyor No. 4012