Job No 70-87 O-1-D

JOHN CIRCLE
ENGINEER SURVEYOR
187 Sinsbury Drive
Worthington, Ohio 43085

Civil Engineer Reg. No. 19137 Professional Surveyor Reg. No. 4340

OWNER KINGS COUNCIL, INC.
ADDRESS [illegible] U.S. 40

Subdivision 4.66 AC Deed 3016 Page 655
County FRANKLIN Lot No. ____ Plat ____ Page ____

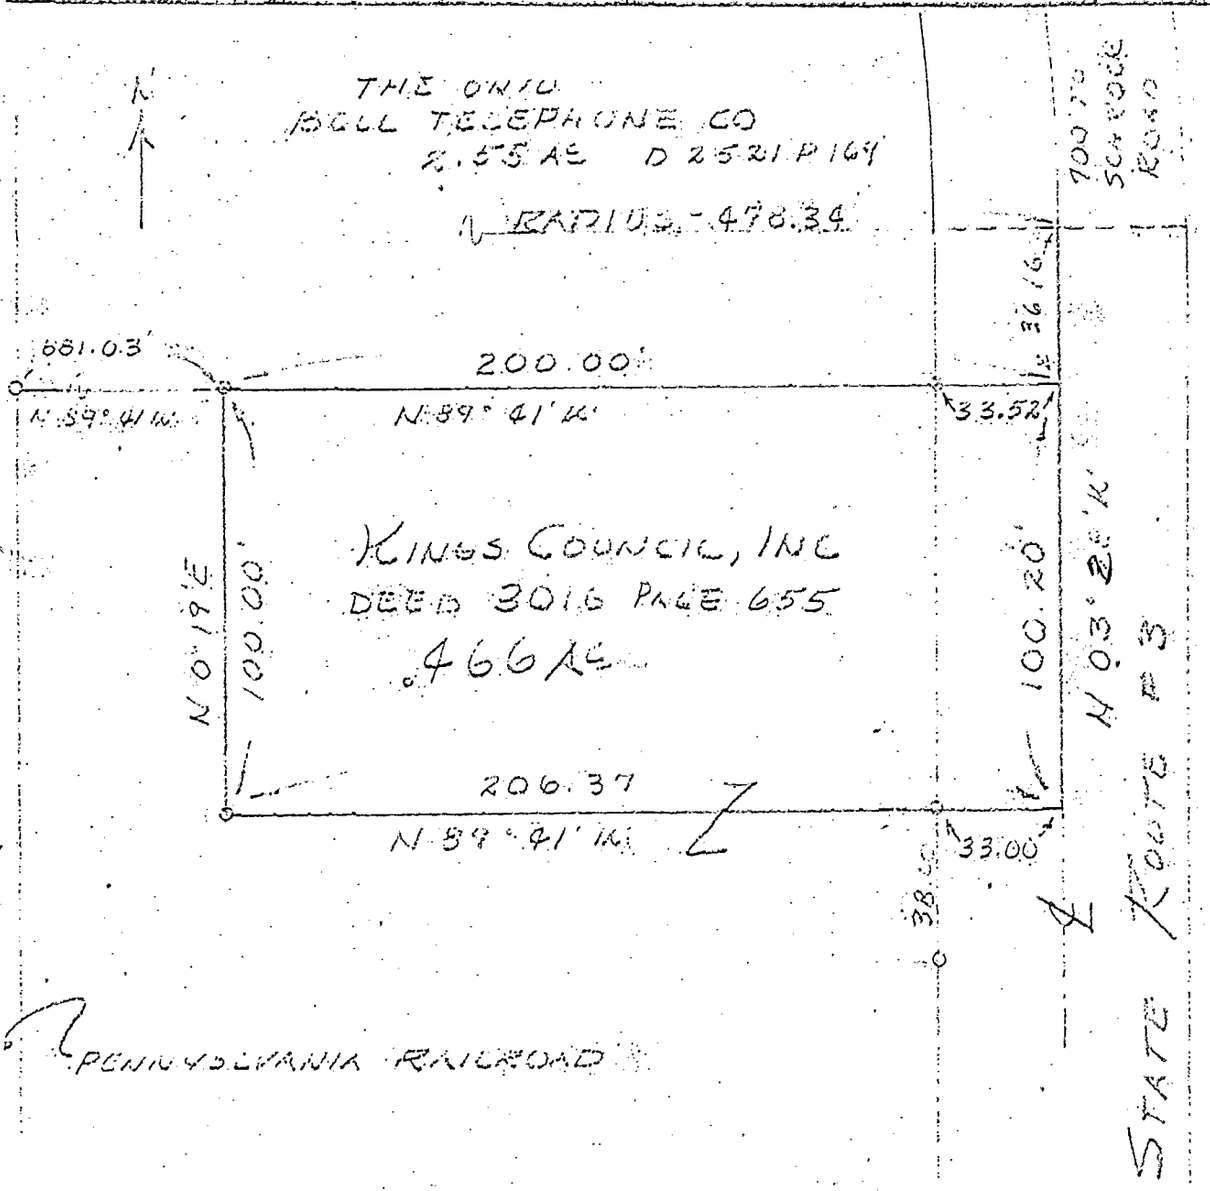

QUARTER TOWNSHIP 2
TOWNSHIP 2
RANGE 17
U.S.M.
FRANKLIN COUNTY, OHIO

LEGEND
Existing Marker
Marker Set

REVISION | No. | DESCRIPTION | DATE

CERTIFICATION: I hereby certify that the above drawing was prepared from an actual survey of the premises and shows the location of the boundaries.

John Circle 12/19/87
John Circle, Engineer-Surveyor DATE

Checked by: ____ Drawn by: ____
Scale: 40 Feet 1 Inch
Drawing No. 3370

© 1969

CITY OF WESTERVILLE

8495-74 75

0 5 1 0 2 3 W S R 3 1 2 0 9 6 0 1 9 6 9 0 0 1 4 0 3 0