


71 (30) FIRESTONE TIRE AND RUBBER CO. ARKON OHIO

PARCEL W. OF S.R.3, S. OF SCHROCK RD., BLENDOEN TOWNSHIP, FRANKLIN COUNTY, STATE OF OHIO

SCALE 1" = 30'

SCALE 1" = 30' DATE 11-20-72 PLAT BOOK PAGE DEED BOOK PAGE

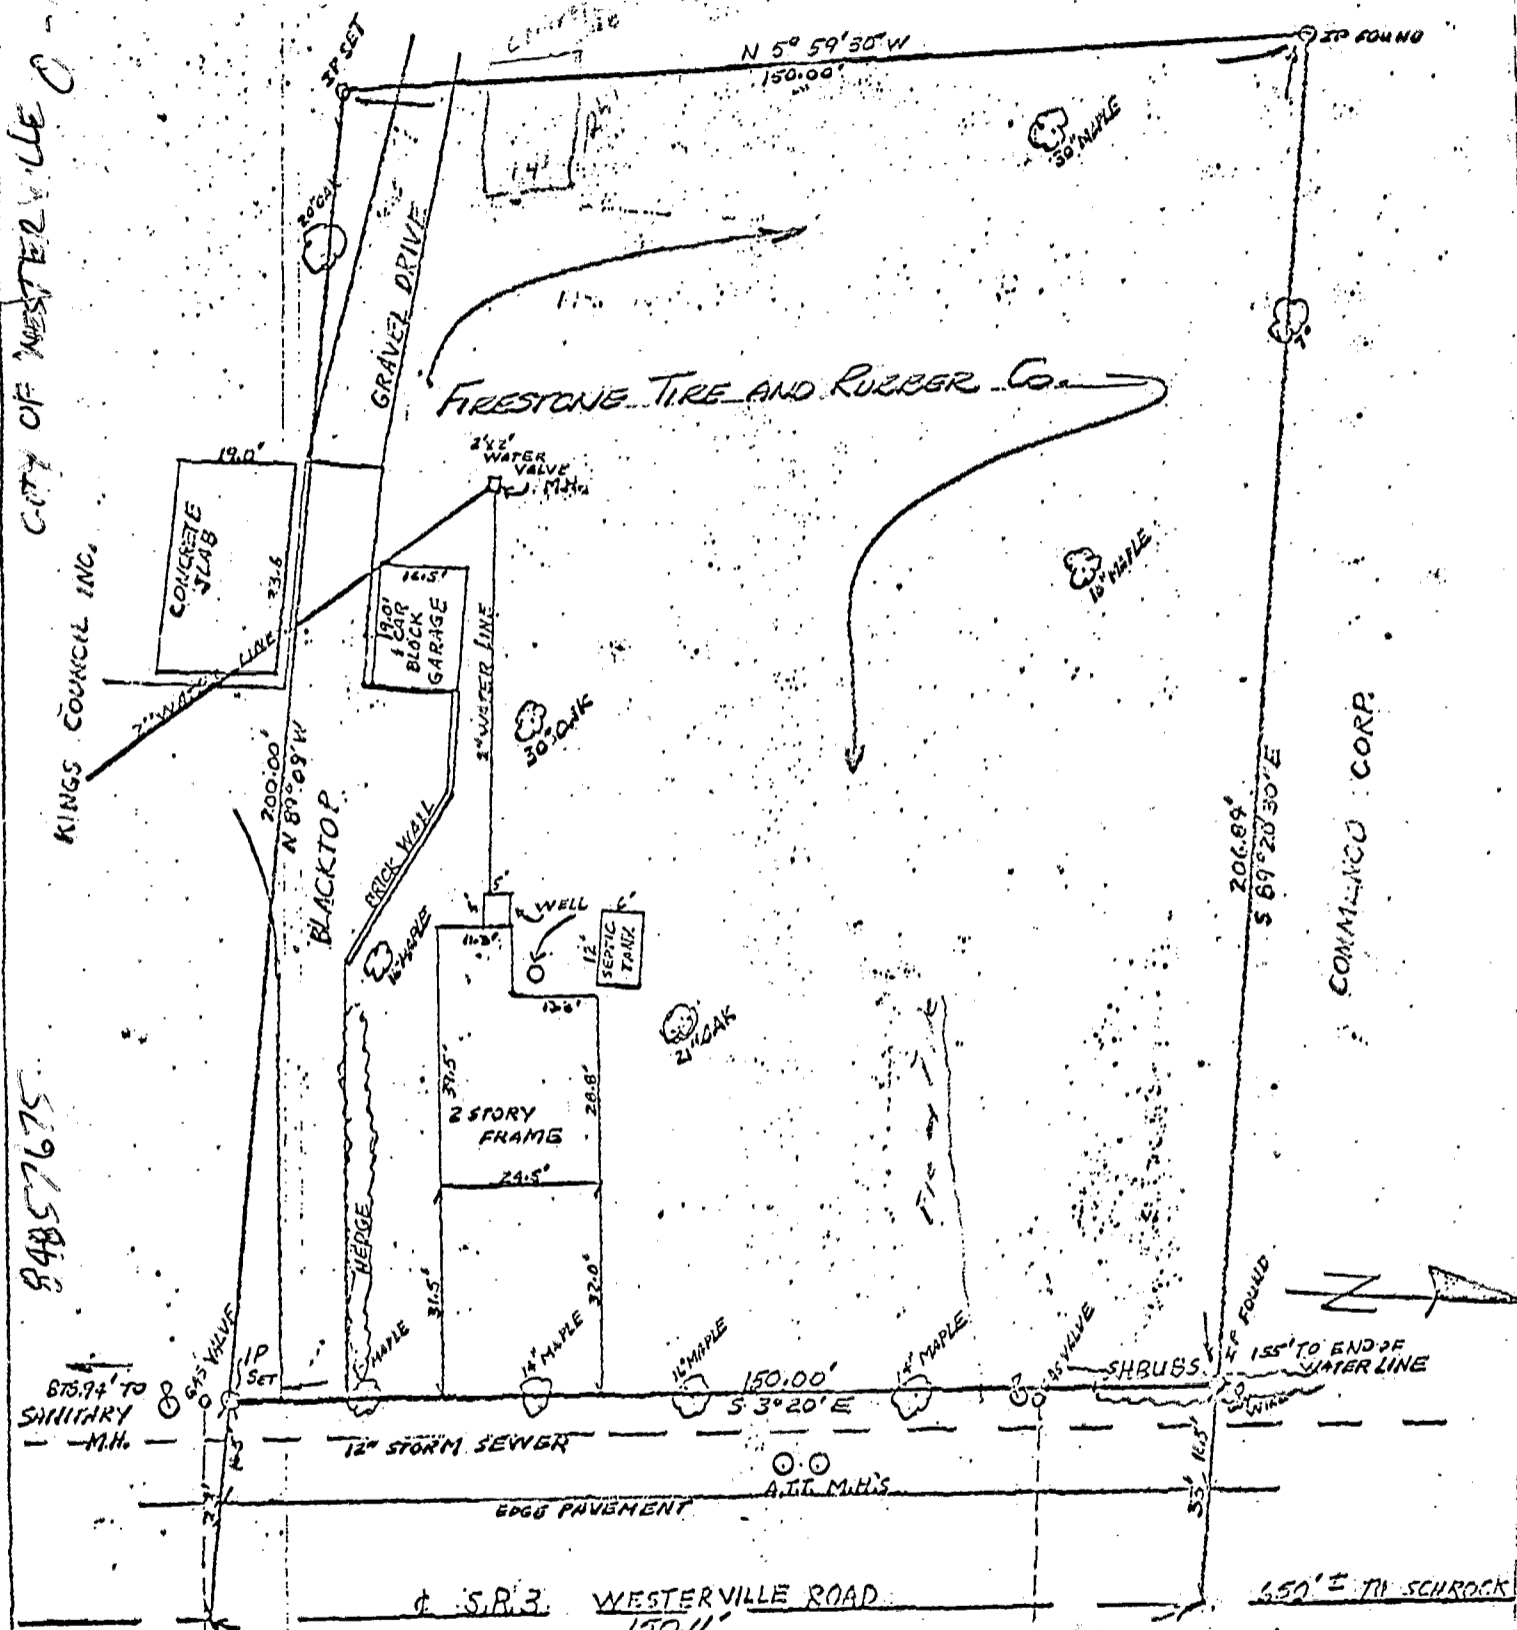

We hereby certify that the foregoing drawing was prepared from an actual survey of the premises. No side line of principal building is less than dimension shown.

*Edward Proctor*  
REGISTERED SURVEYOR NO. 52

DRAWN BY J.R.F.

S. D. POMEROY  
ENGINEERING & SURVEYING

SSO East Broad Street

Columbus, Ohio 43205

030  
0014  
1970  
3  
049 021 WSR  
120  
0960