

EVANS MECHWART HAMBLETON & TILTON, INC.

18510 7675
18535 7675

CONSULTING ENGINEERS — SURVEYORS
GAHANNA, OHIO

M-204 ~~333~~


C.C.C.

SURVEY MAP OF 0.043 ACRE OF LAND IN RESERVE "N" OF LAKESIDE FOREST LOCATED NORTH OF EAST SCHROCK ROAD AND WEST OF WOODVIEW ROAD IN THE CITY OF WESTERVILLE, COUNTY OF FRANKLIN, STATE OF OHIO

SCALE 1" = 30' JULY 17, 1985

(TRACT 13)

DEED BOOK _____, PAGE _____
PLAT BOOK 57, PAGE 90, 91 & 92

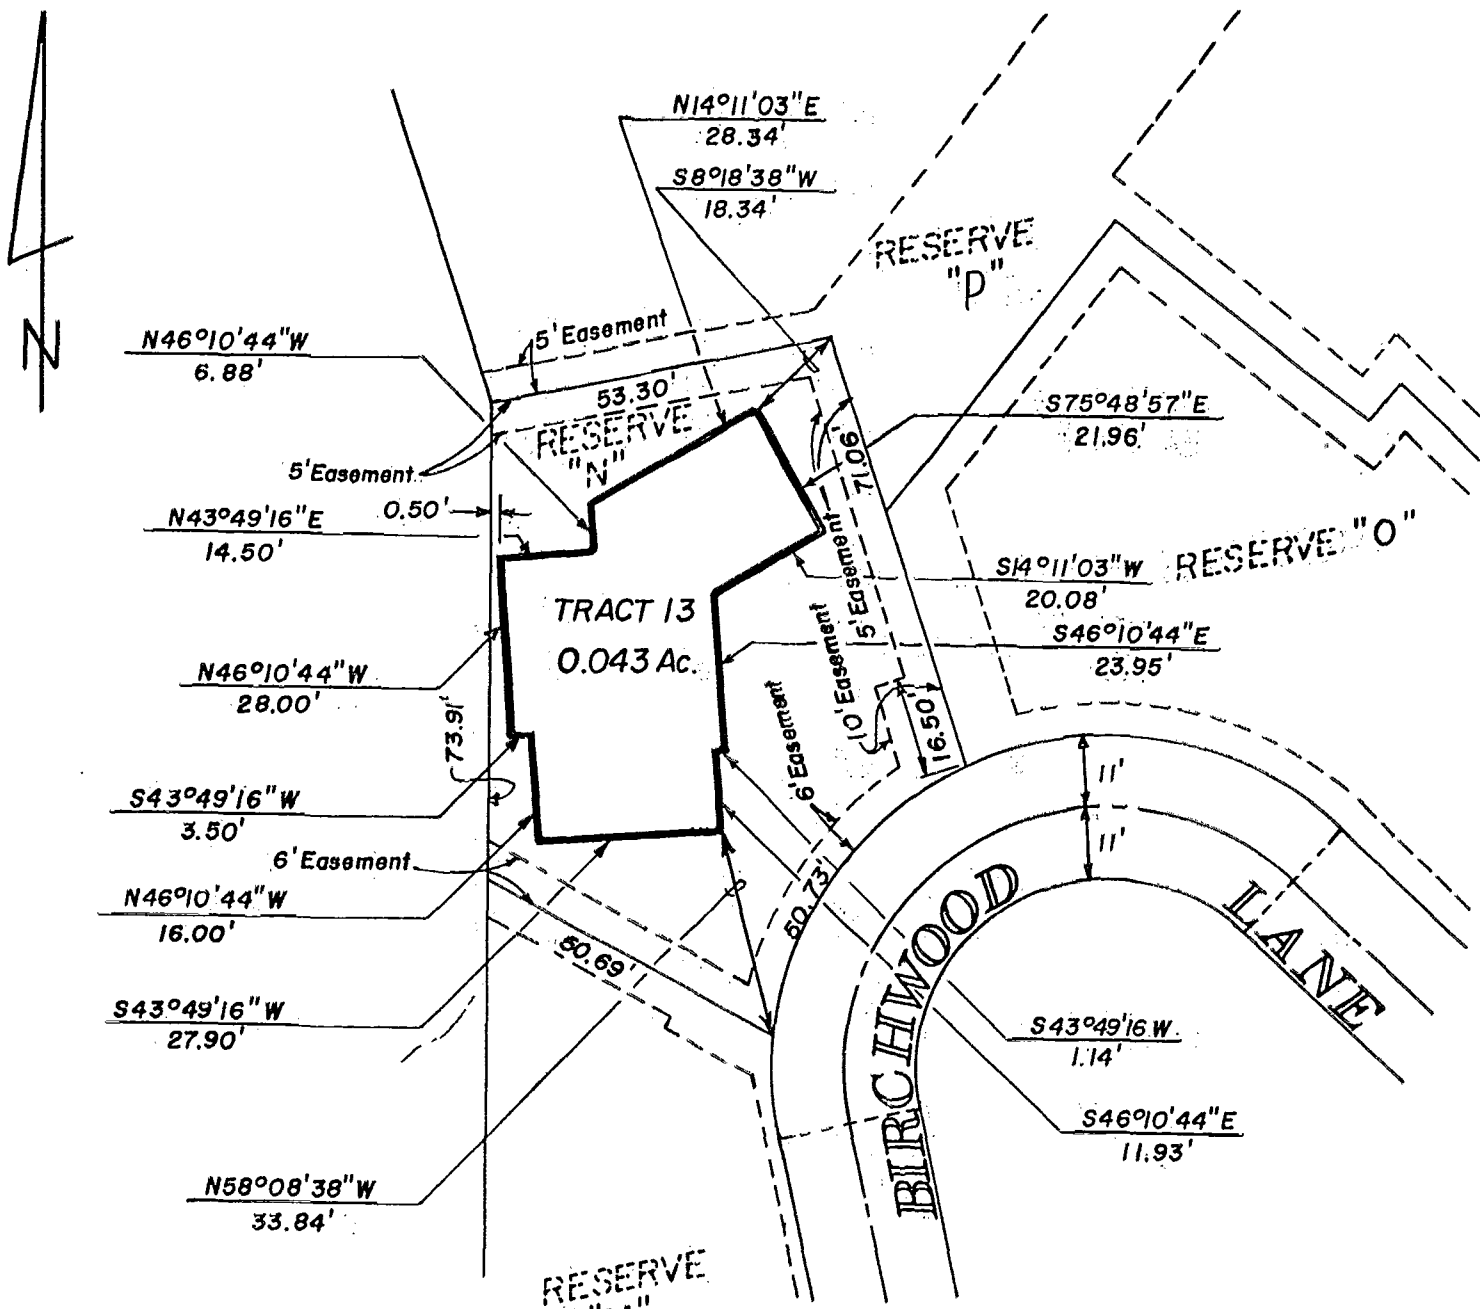

The boundary lines of the 0.043 acre tract shown hereon are coincident with the exterior faces of the foundation wall of an existing residential structure.

The easements shown hereon are easements shown and delineated upon the recorded plat of Lakeside Forest.

Situated in the State of Ohio, County of Franklin, City of Westerville, being in Lot 4, Section 2, Township 2, Range 17, United States Military Lands, being 0.043 acre of land, more or less, said 0.043 acre being out of Reserve "N" as the same is designated and delineated upon the recorded plat of Lakeside Forest of record in Plat Book 57, Pages 90, 91 and 92, Recorder's Office, Franklin County, Ohio.

We hereby certify that the above map was prepared from information obtained from an actual field survey of the premises conducted by Evans Mechwart Hambleton & Tilton, Inc. on July 17, 1985 and that, to the best of our knowledge and belief, said map is correct.

The bearings shown on the above map correspond to the bearings shown on the recorded plat of Lakeside Forest of record in Plat Book 57, Pages 90, 91 and 92, Recorder's Office, Franklin County, Ohio.

EVANS MECHWART HAMBLETON & TILTON, INC.
[Signature]