


BAUER, BOROWITZ & MERCHANT, INC.

185357675

CONSULTING ENGINEERS

2607 1/2 NORTH HIGH STREET

COLUMBUS, OHIO 43202

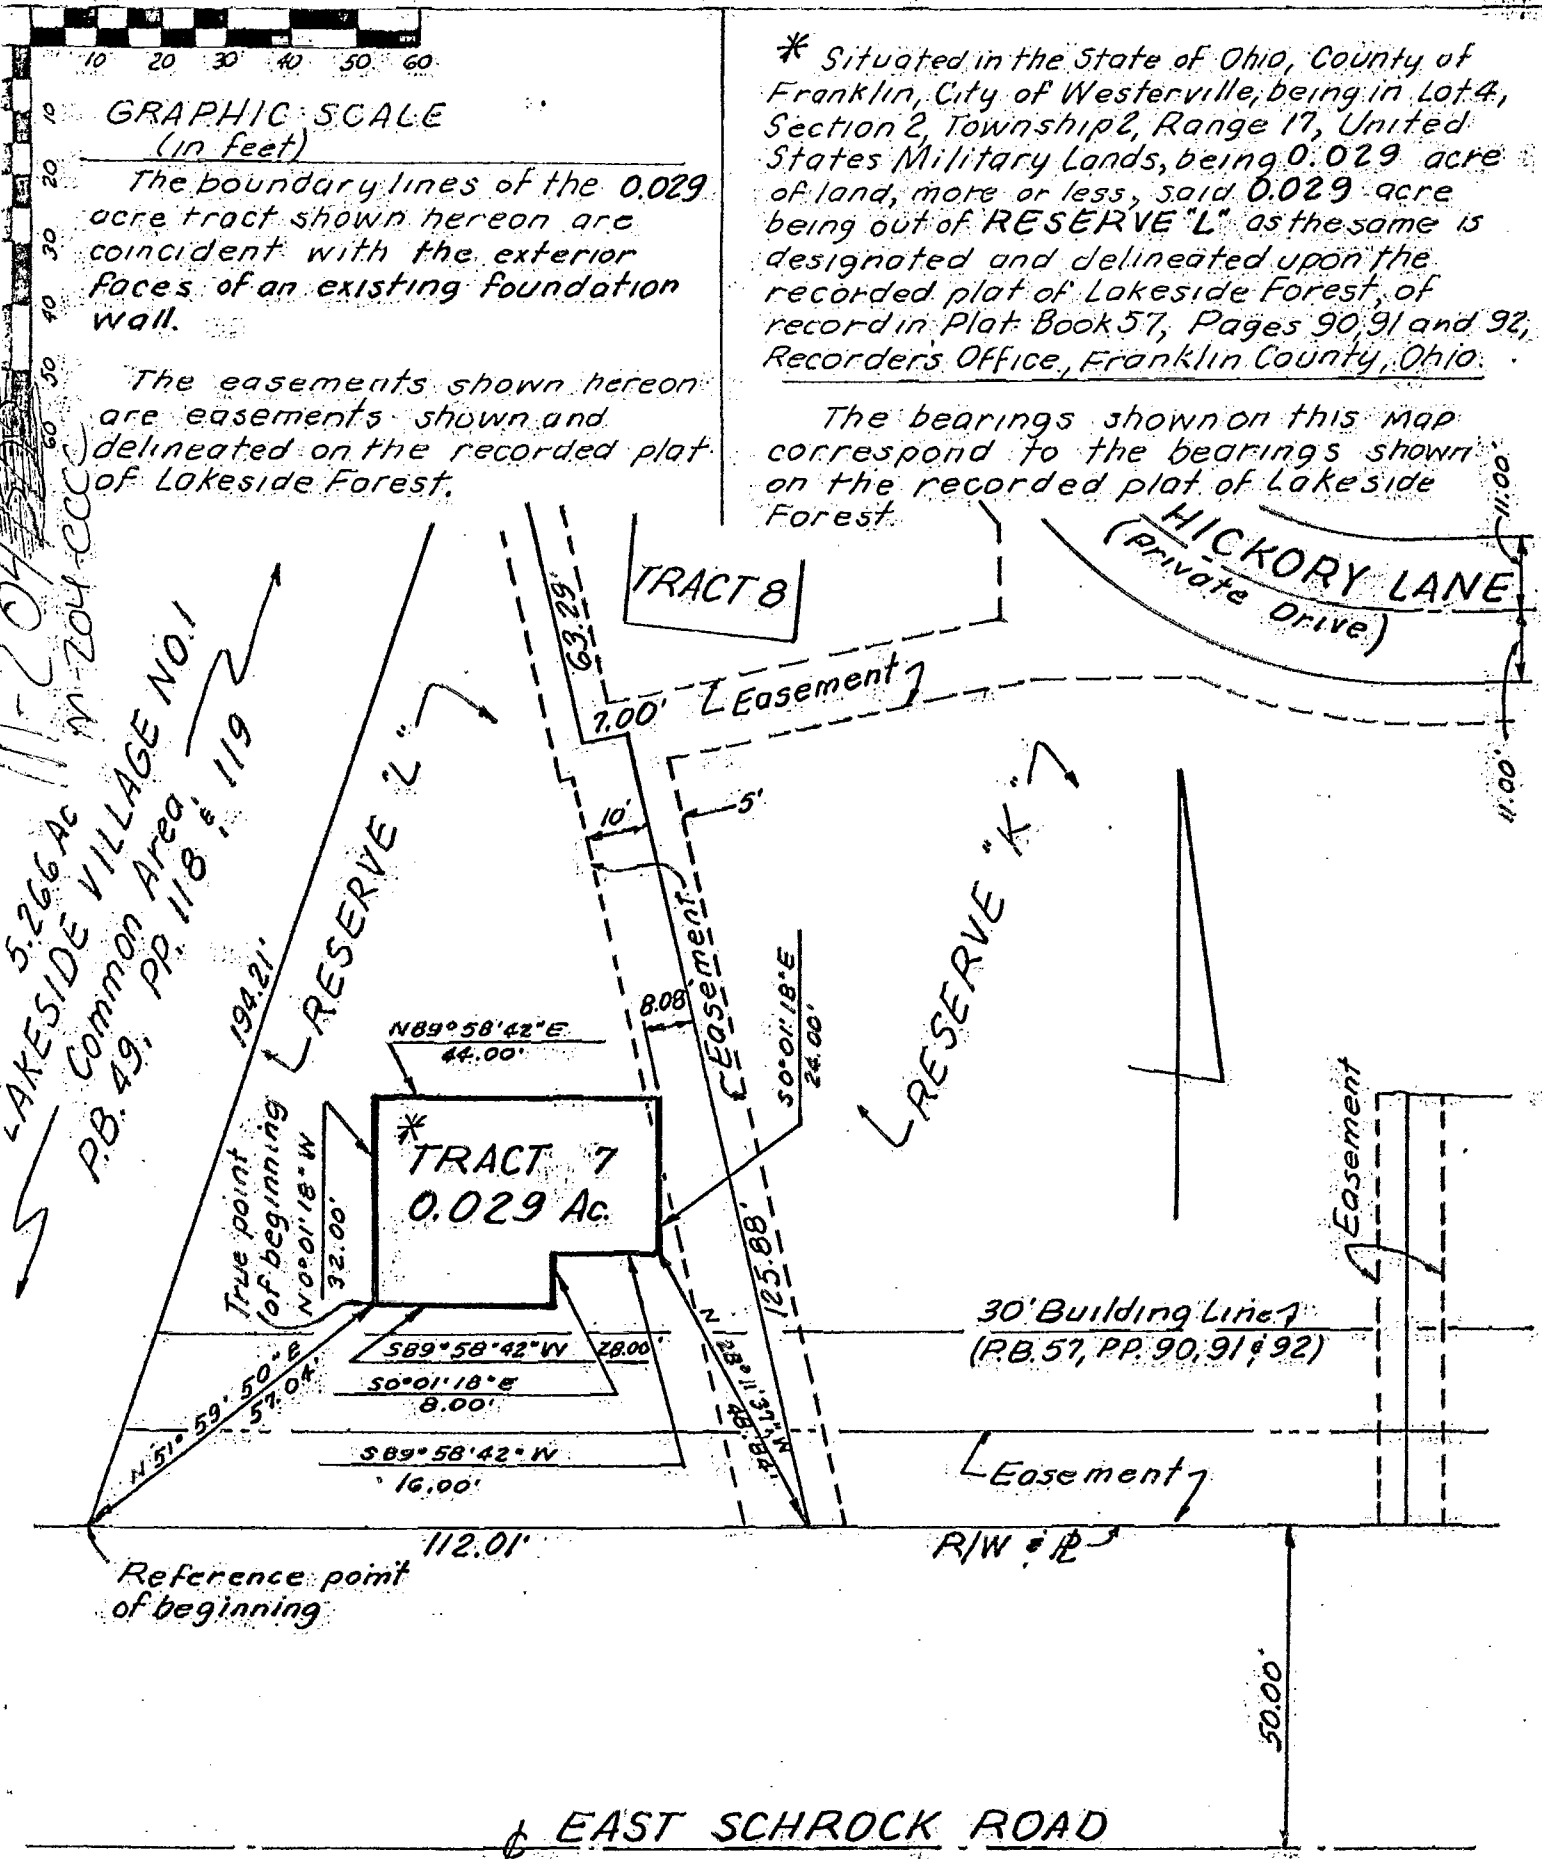

* Situated in the State of Ohio, County of Franklin, City of Westerville, being in Lot 4, Section 2, Township 2, Range 17, United States Military Lands, being 0.029 acre of land, more or less, said 0.029 acre being out of RESERVE "L" as the same is designated and delineated upon the recorded plat of Lakeside Forest, of record in Plat Book 57, Pages 90, 91 and 92, Recorder's Office, Franklin County, Ohio.

The bearings shown on this map correspond to the bearings shown on the recorded plat of Lakeside Forest.

M-204
M-204-CCC
LAKE SIDE VILLAGE NO. 1
Common Area
P.B. 49, PP. 118 & 119
5.266 Ac

We hereby certify that this map is based on information obtained during an actual field survey conducted by Bauer, Borowitz & Merchant, Inc. on May 20, 1983, and that, to the best of our knowledge and belief, said map is correct.

SURVEY MAP
OF 0.029 ACRE OF LAND
IN RESERVE "L" OF LAKE SIDE
FOREST, LOCATED NORTH OF
EAST SCHROCK ROAD AND WEST
OF WOODVIEW ROAD IN THE CITY
OF WESTERVILLE, COUNTY
OF FRANKLIN, STATE OF OHIO
(TRACT 7)

BAUER, BOROWITZ & MERCHANT, INC.
Consulting Engineers
Elmer R. Borowitz
Elmer R. Borowitz
Registered Surveyor No. 5561

May 25, 1983
Scale: 1" = 30'
Order No. 863-83