


A Survey Plat of
 0.0367 acres of land in Reserve "I" of Lake-
 side Forest located in the City of Westerville,
 Franklin County, Ohio. (Tract 1) For
 State Savings Bank or Commonwealth Land Title Ins. Co.

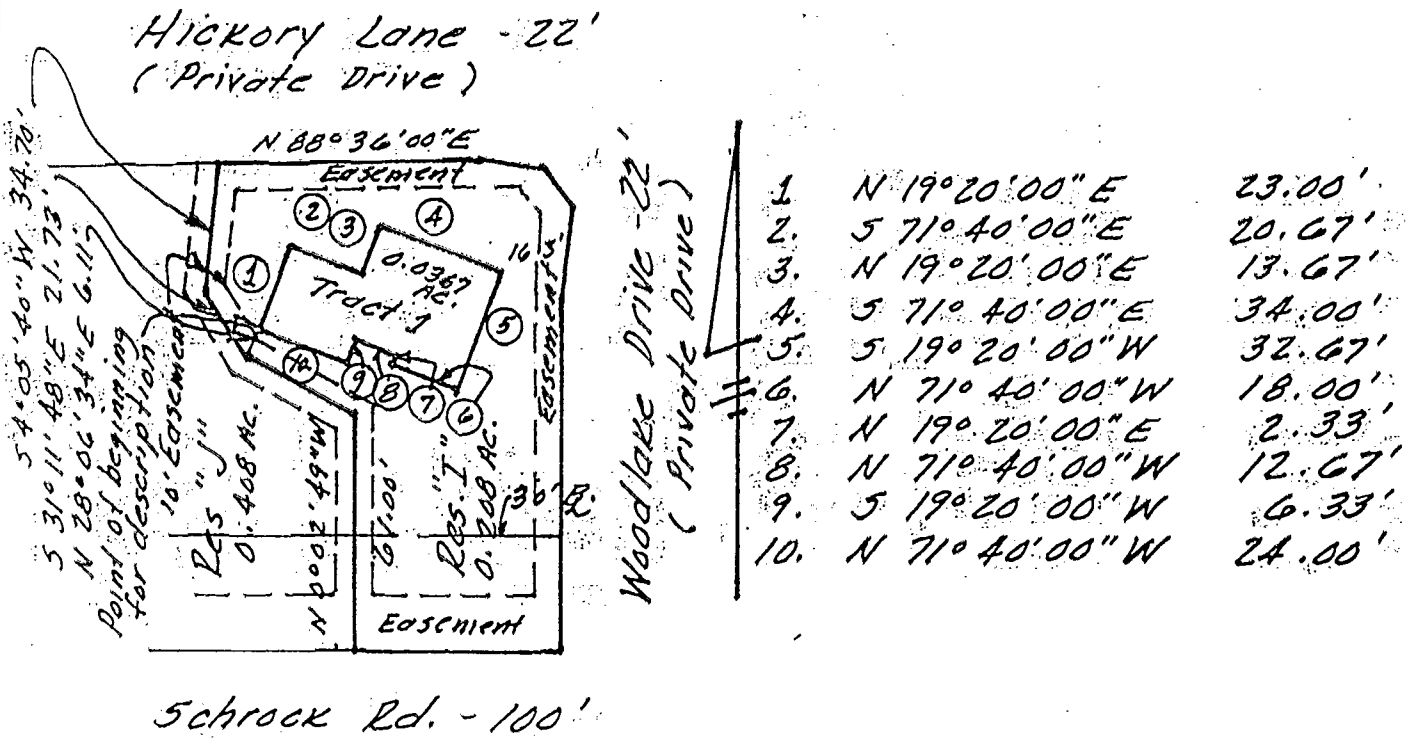


The boundary lines of the 0.0367 acre tract shown hereon are coincident with the exterior faces of the foundation walls of an existing residential structure.

The easements shown hereon are numbered and delineated upon the record plat of said Lakeside Forest.

Situated in the State of Ohio, County of Franklin, City of Westerville, being in lot 4, Section 2, Township 2, Range 17, United States Military Lands, and being 0.0367 acres of land out of Reserve "I" as the same is numbered and delineated upon the record plat of Lakeside Forest, shown of record in plat book 57, pages 90 and 91, Recorder's Office, Franklin County, Ohio.

The bearings shown on the attached plat correspond to the bearings shown on the record plat of Lakeside Forest.

I do hereby certify that the attached plat was prepared from an actual field survey of the premises shown hereon, and that to the best of my knowledge said plat is correct.

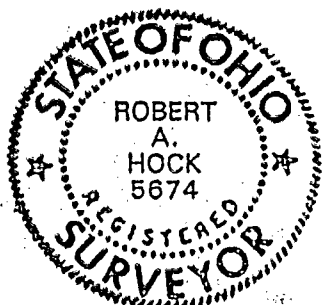

Pat & Dianna O'Reilly Residence
 T.W.R. - Builders

Hock Surveying Co.
 5440 Darcy Rd.
 Columbus, Ohio 43229
 614-846-2059

June 19, 1989
 Scale: 1" = 50'

Robert A. Hock
 Robert A. Hock - Ohio Surv. 5674