BAUER, DAVIDSON & MERCHANT, INC.
CONSULTING ENGINEERS
2607½ NORTH HIGH STREET COLUMBUS, OHIO 43202

18535-7650

M-204-

SURVEY MAP OF THE SUBDIVISION OF RESERVE "F" OF MEADOWLAKE SECTION TWO, LOCATED SOUTH OF HUBER VILLAGE BOULEVARD AND WEST OF TRADEWIND DRIVE, IN THE CITY OF WESTERVILLE, COUNTY OF FRANKLIN, STATE OF OHIO

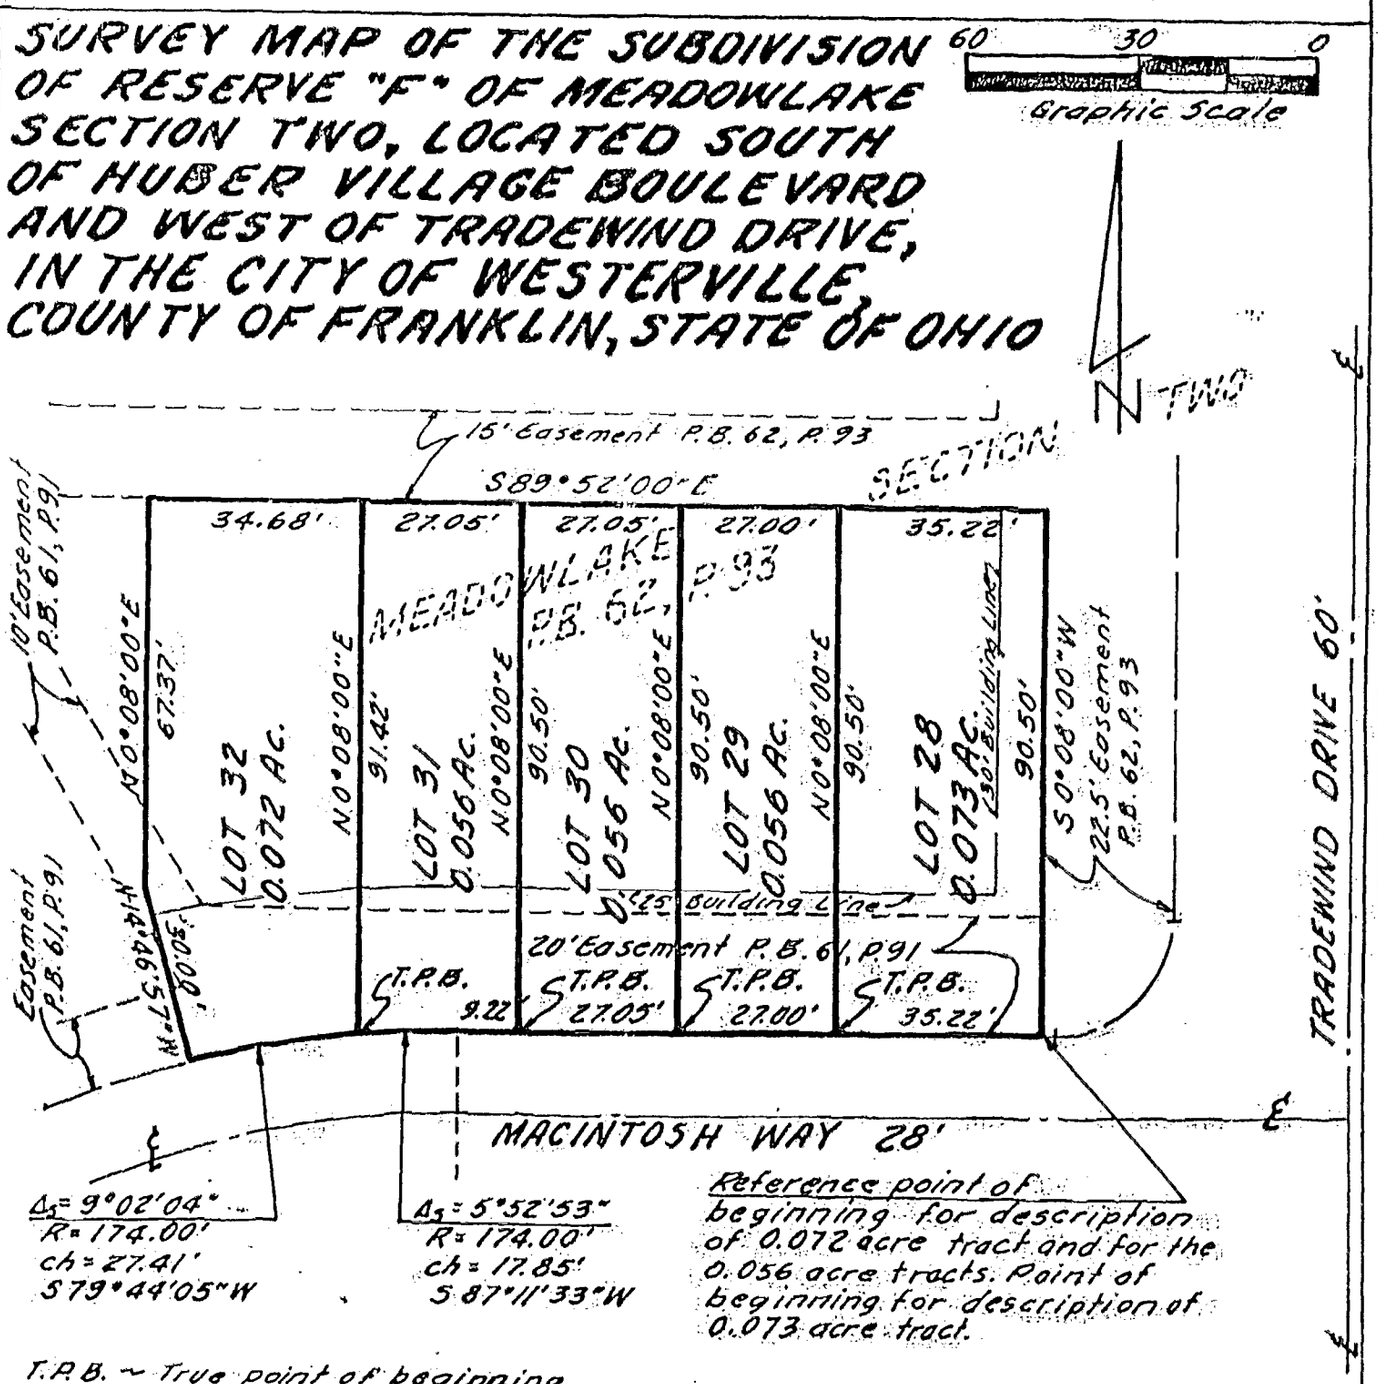

T.P.B. ~ True point of beginning for description

The 0.072 acre tract, 0.056 acre tracts and the 0.073 acre tract of land shown hereon are situated in the State of Ohio, County of Franklin, City of Westerville, are part of Section 2, Township 2 North, Range 17 West, United States Military Lands and are in RESERVE "F" as the same is designated and delineated upon the recorded plat of Meadowlake Section Two, of record in Plat Book 62, Page 93, Recorder's Office, Franklin County, Ohio.

We hereby certify that this map was prepared from information obtained from an as-built location survey of the structure situated on said RESERVE "F" conducted by Bauer, Davidson & Merchant, Inc. on July 3, 1986.

The bearings shown on this map correspond to the bearings shown on said recorded plat of Meadowlake Section Two.

Scale: 1" = 30'
Order No. 1954-86
July 24, 1986

BAUER, DAVIDSON & MERCHANT, INC.
CONSULTING ENGINEERS

By: John W. McCombs
John W. McCombs
Professional Surveyor No. 6661