

BAUER, DAVIDSON & MERCHANT, INC.

185857675

CONSULTING ENGINEERS


M-254-EE

2607 1/2 NORTH HIGH STREET

COLUMBUS, OHIO 43202



**MAP OF A 0.011
ACRE TRACT OF LAND LOCATED
EAST OF HEMPSTEAD ROAD AND
SOUTH OF WALNUT STREET IN
THE CITY OF WESTERVILLE,
COUNTY OF FRANKLIN,
STATE OF OHIO**

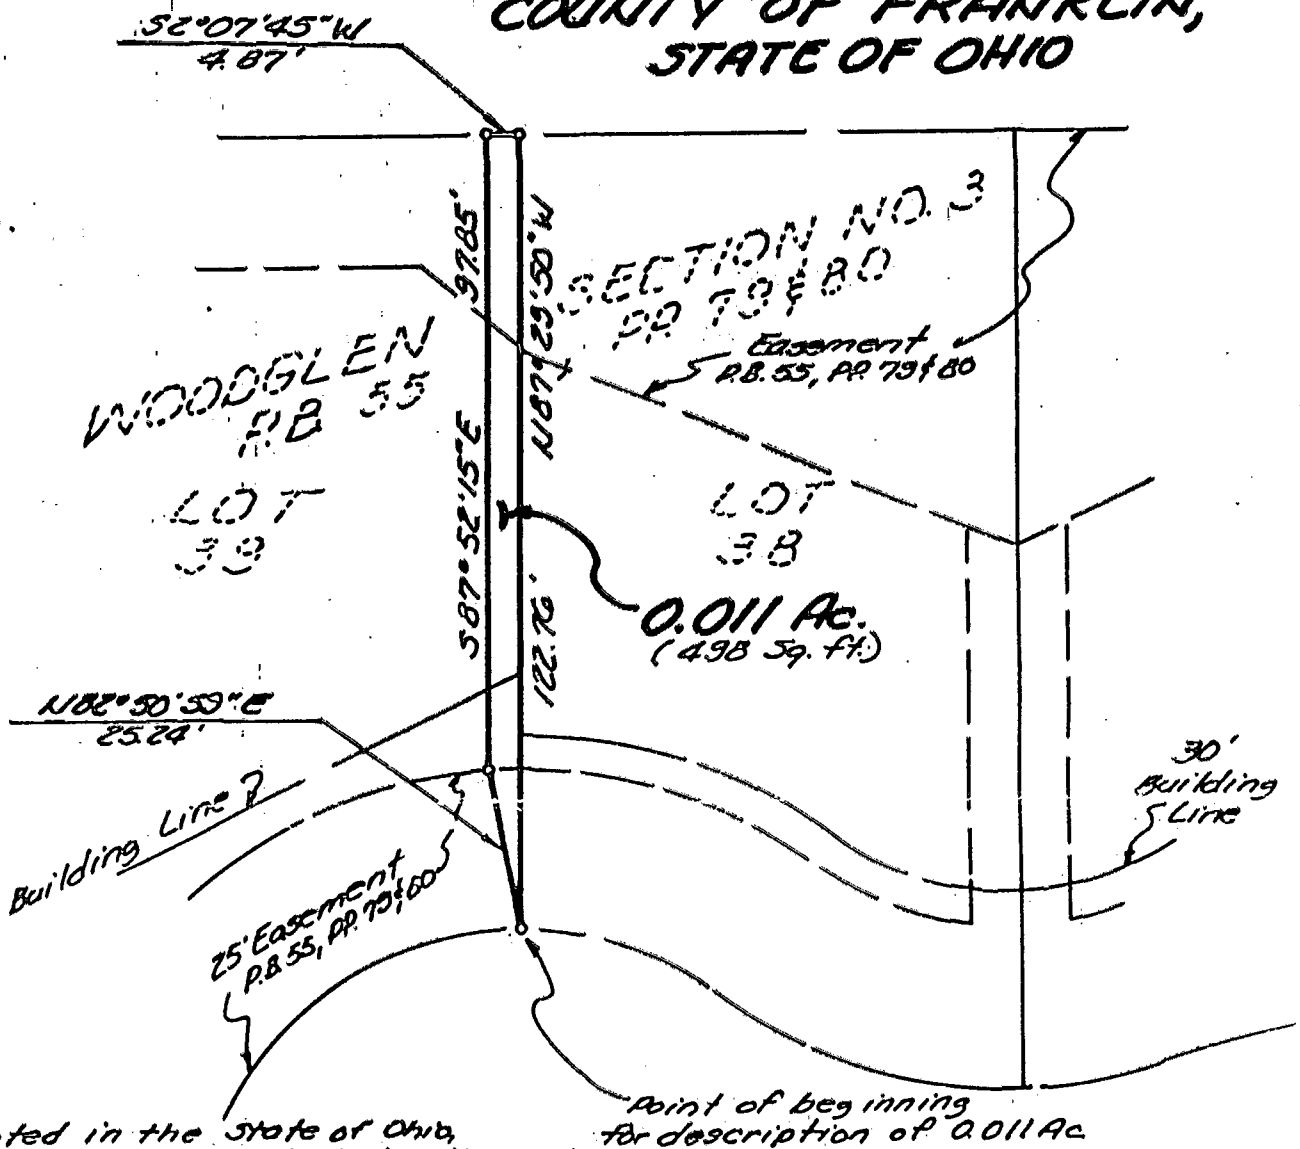

Situated in the State of Ohio, County of Franklin, City of Westerville, being a part of Section 1, Township 2 Range 17, United States Military Lands, being a 0.011 acre tract of land more or less, said 0.011 acre being part of Lot 39, as the same is numbered and delineated upon the recorded plat of Woodglen Section No. 3, of record in Plat Book 55, Pages 79 and 80, Recorder's Office, Franklin County, Ohio.

The bearings shown on the above map correspond to the bearings shown on the recorded plat of said Woodglen Section No. 3.

We hereby certify that the above map was prepared from information obtained from an actual field survey of the premises conducted by Bauer, Davidson & Merchant, Inc. in June of 1985.

Bauer, Davidson & Merchant, Inc.
Consulting Engineers

June 24, 1985 Ord. No. 1269-85

Scale: 1" = 30'

By

Gatis Erenpreks

Gatis Erenpreks
Professional Surveyor No. 5572