

EVANS MECHWART HAMBLETON & TILTON

CIVIL ENGINEERS — SURVEYORS
GAHANNA, OHIO.

Situate in the County of Franklin, State of Ohio, Town-
ship of Blendon, Being a Part of Lot 4 of Joseph Chapham's
Heir's Subdivision of a Part of Quarter Township 1, Township 2,
Range 17, United States Military Lands:


SCALE 1" = 100'
Revised April 8, 1968

September 24, 1962
o = Iron Pin

DEED BOOK _____ PAGE _____
PLAT BOOK 17 PAGE 108

REVISED: November 26, 1962 to show two 1.005 Acre Tracts.

Southwest corner of a tract conveyed to the
City of Columbus by deed recorded in Vol. 1697
Page 259.

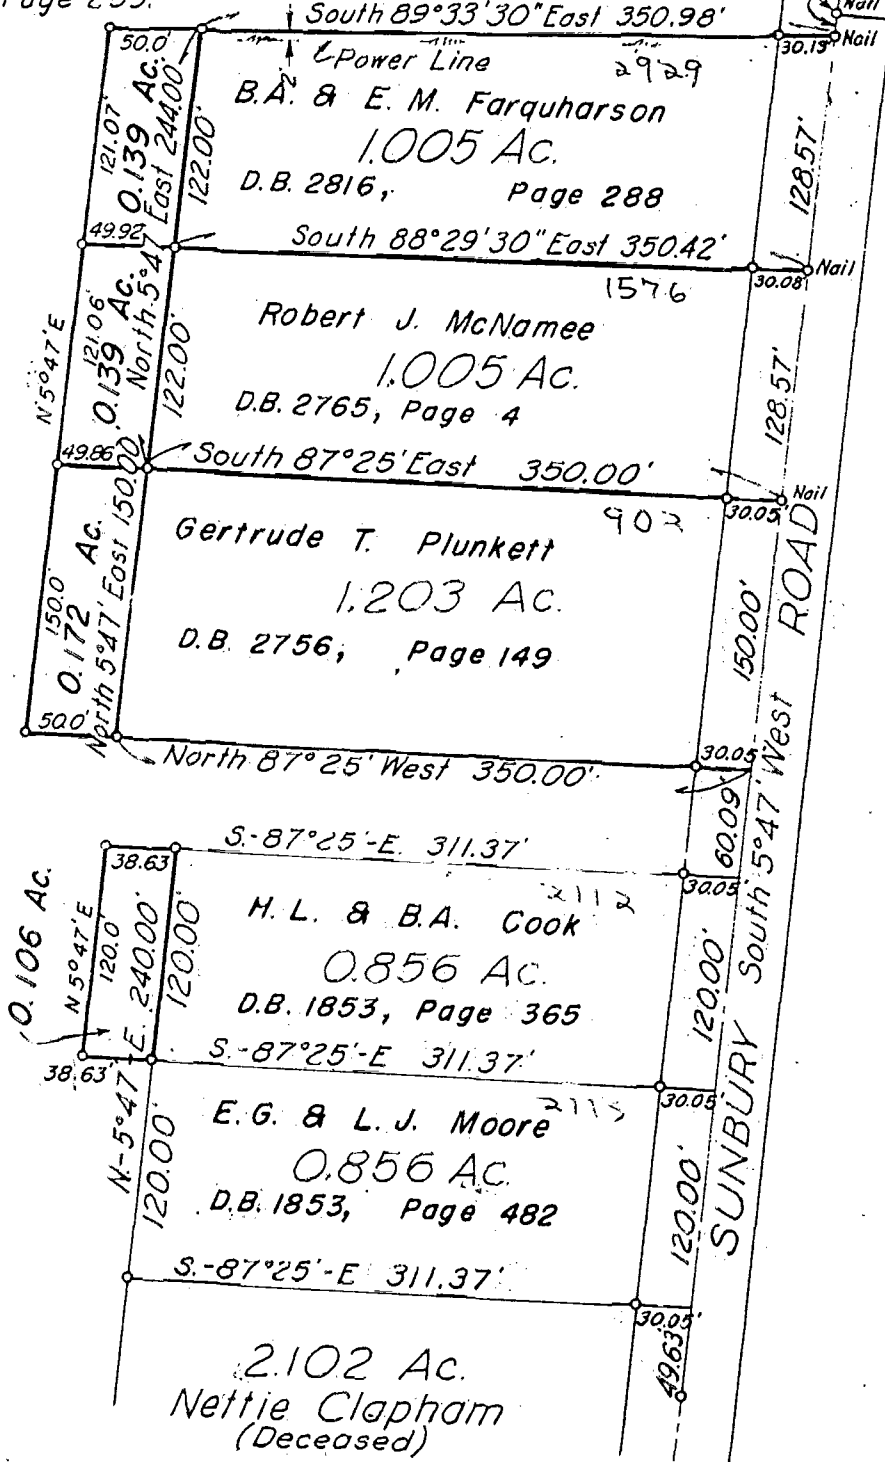

We hereby certify that the foregoing plat was prepared from an actual survey of the premises and shows the location of the boundaries

EVANS MECHWART HAMBLETON & TILTON

BY [Signature]
Registered Surveyor # 4072

6265-54

875

1804-62 1494-62

CITY OF WESTERVILLE

8585 7675

03
0023
1962
SUNBURY S WALKWAY