CITY OF WESTERVILLE

0-2-C

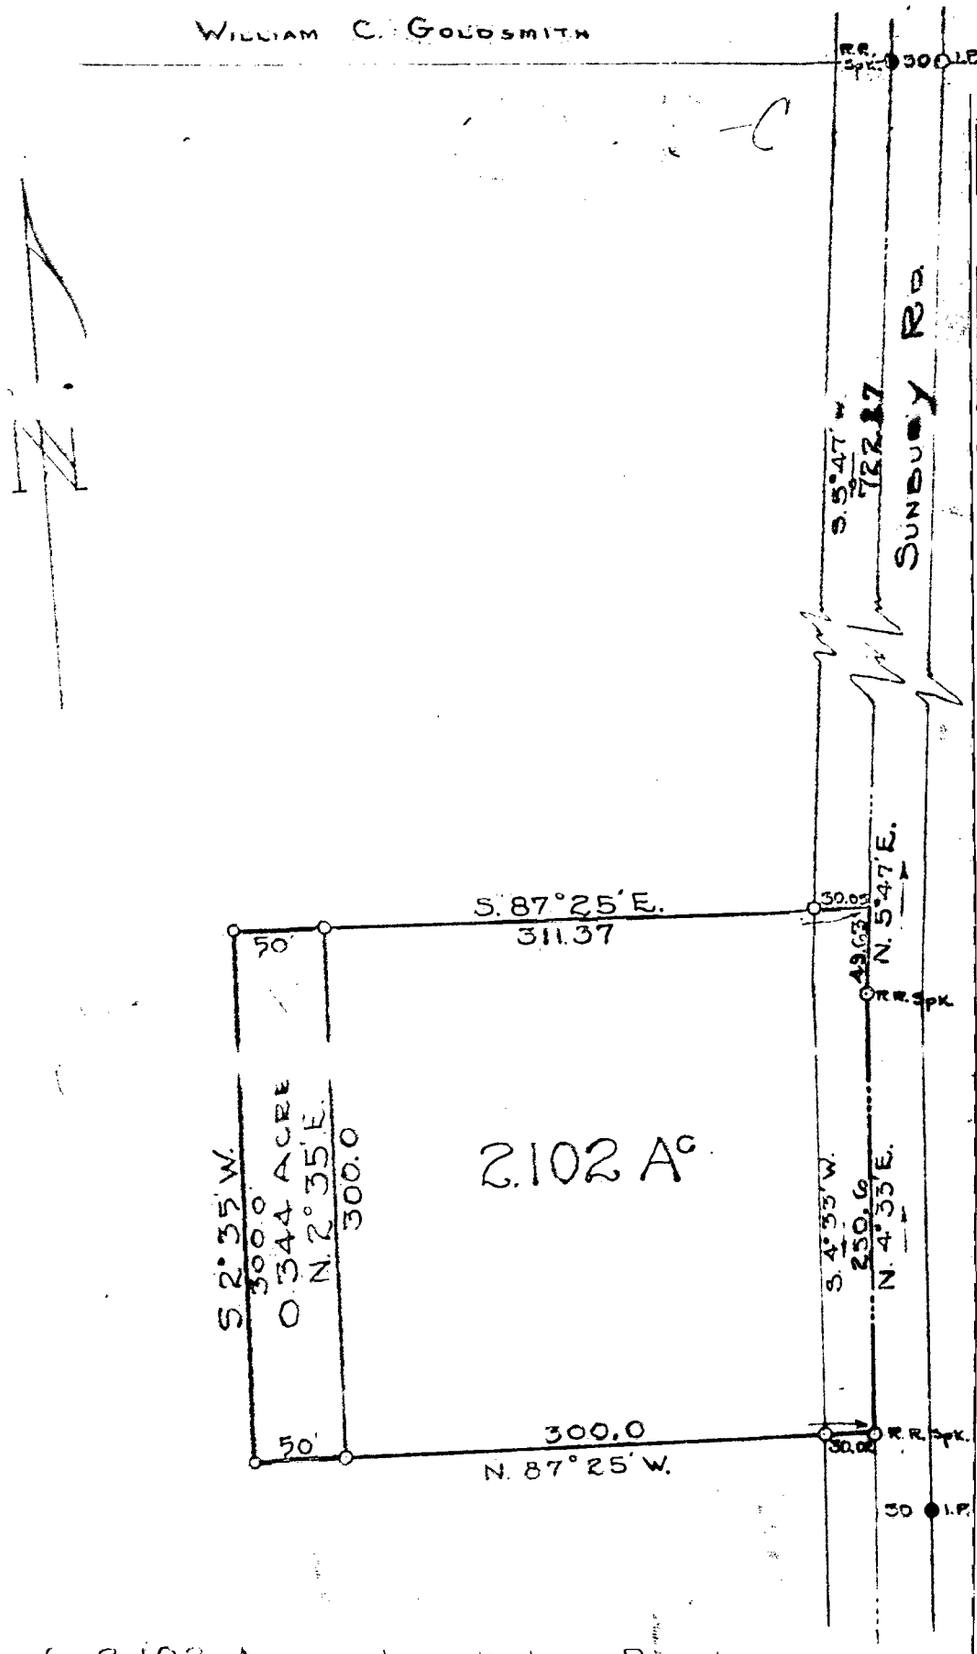

Survey of 2.102 Acres. Located in Blendon Twp., Franklin Co. Ohio & being part of Lot 4 of Joseph Clapham's Heirs' Subdivision of a part of ¼ Twp. No 1, Tp. 2, Range 17, U.S.M.L., Plat Book 17, Page 108, Recorder's Office Franklin Co., Ohio. Date March 17, 1950. Scale 1" = 100' ● = Iron pipe found ○ = Iron pipe set.

Revised May 2, 1968 to show 0.344 Acre Tract

85857700

44 10 120 032 037 W 3 4 6 4 2 1 12 1950 0028 03