E.M.H.&T.
CONSULTING ENGINEERS & SURVEYORS
GAHANNA, OHIO 43230

SURVEY OF ACREAGE PARCEL

LOCATED IN N.E. QUARTER SECTION 1, TOWNSHIP 2, RANGE 17
UNITED STATES MILITARY LANDS
BLENDON TOWNSHIP, FRANKLIN COUNTY, OHIO

SCALE 1" = 50'

o = IRON PIN SET
● = IRON PIN FOUND

FEBRUARY 12, 1999

50' 0' 50' 100'
GRAPHIC SCALE

BASIS OF BEARINGS : Bearings contained herein are based on the same meridian as the bearing of the easterly right-of-way line of Cubbage Road (North 01°39'00" West), of record in Deed Book 3150, Page 241.

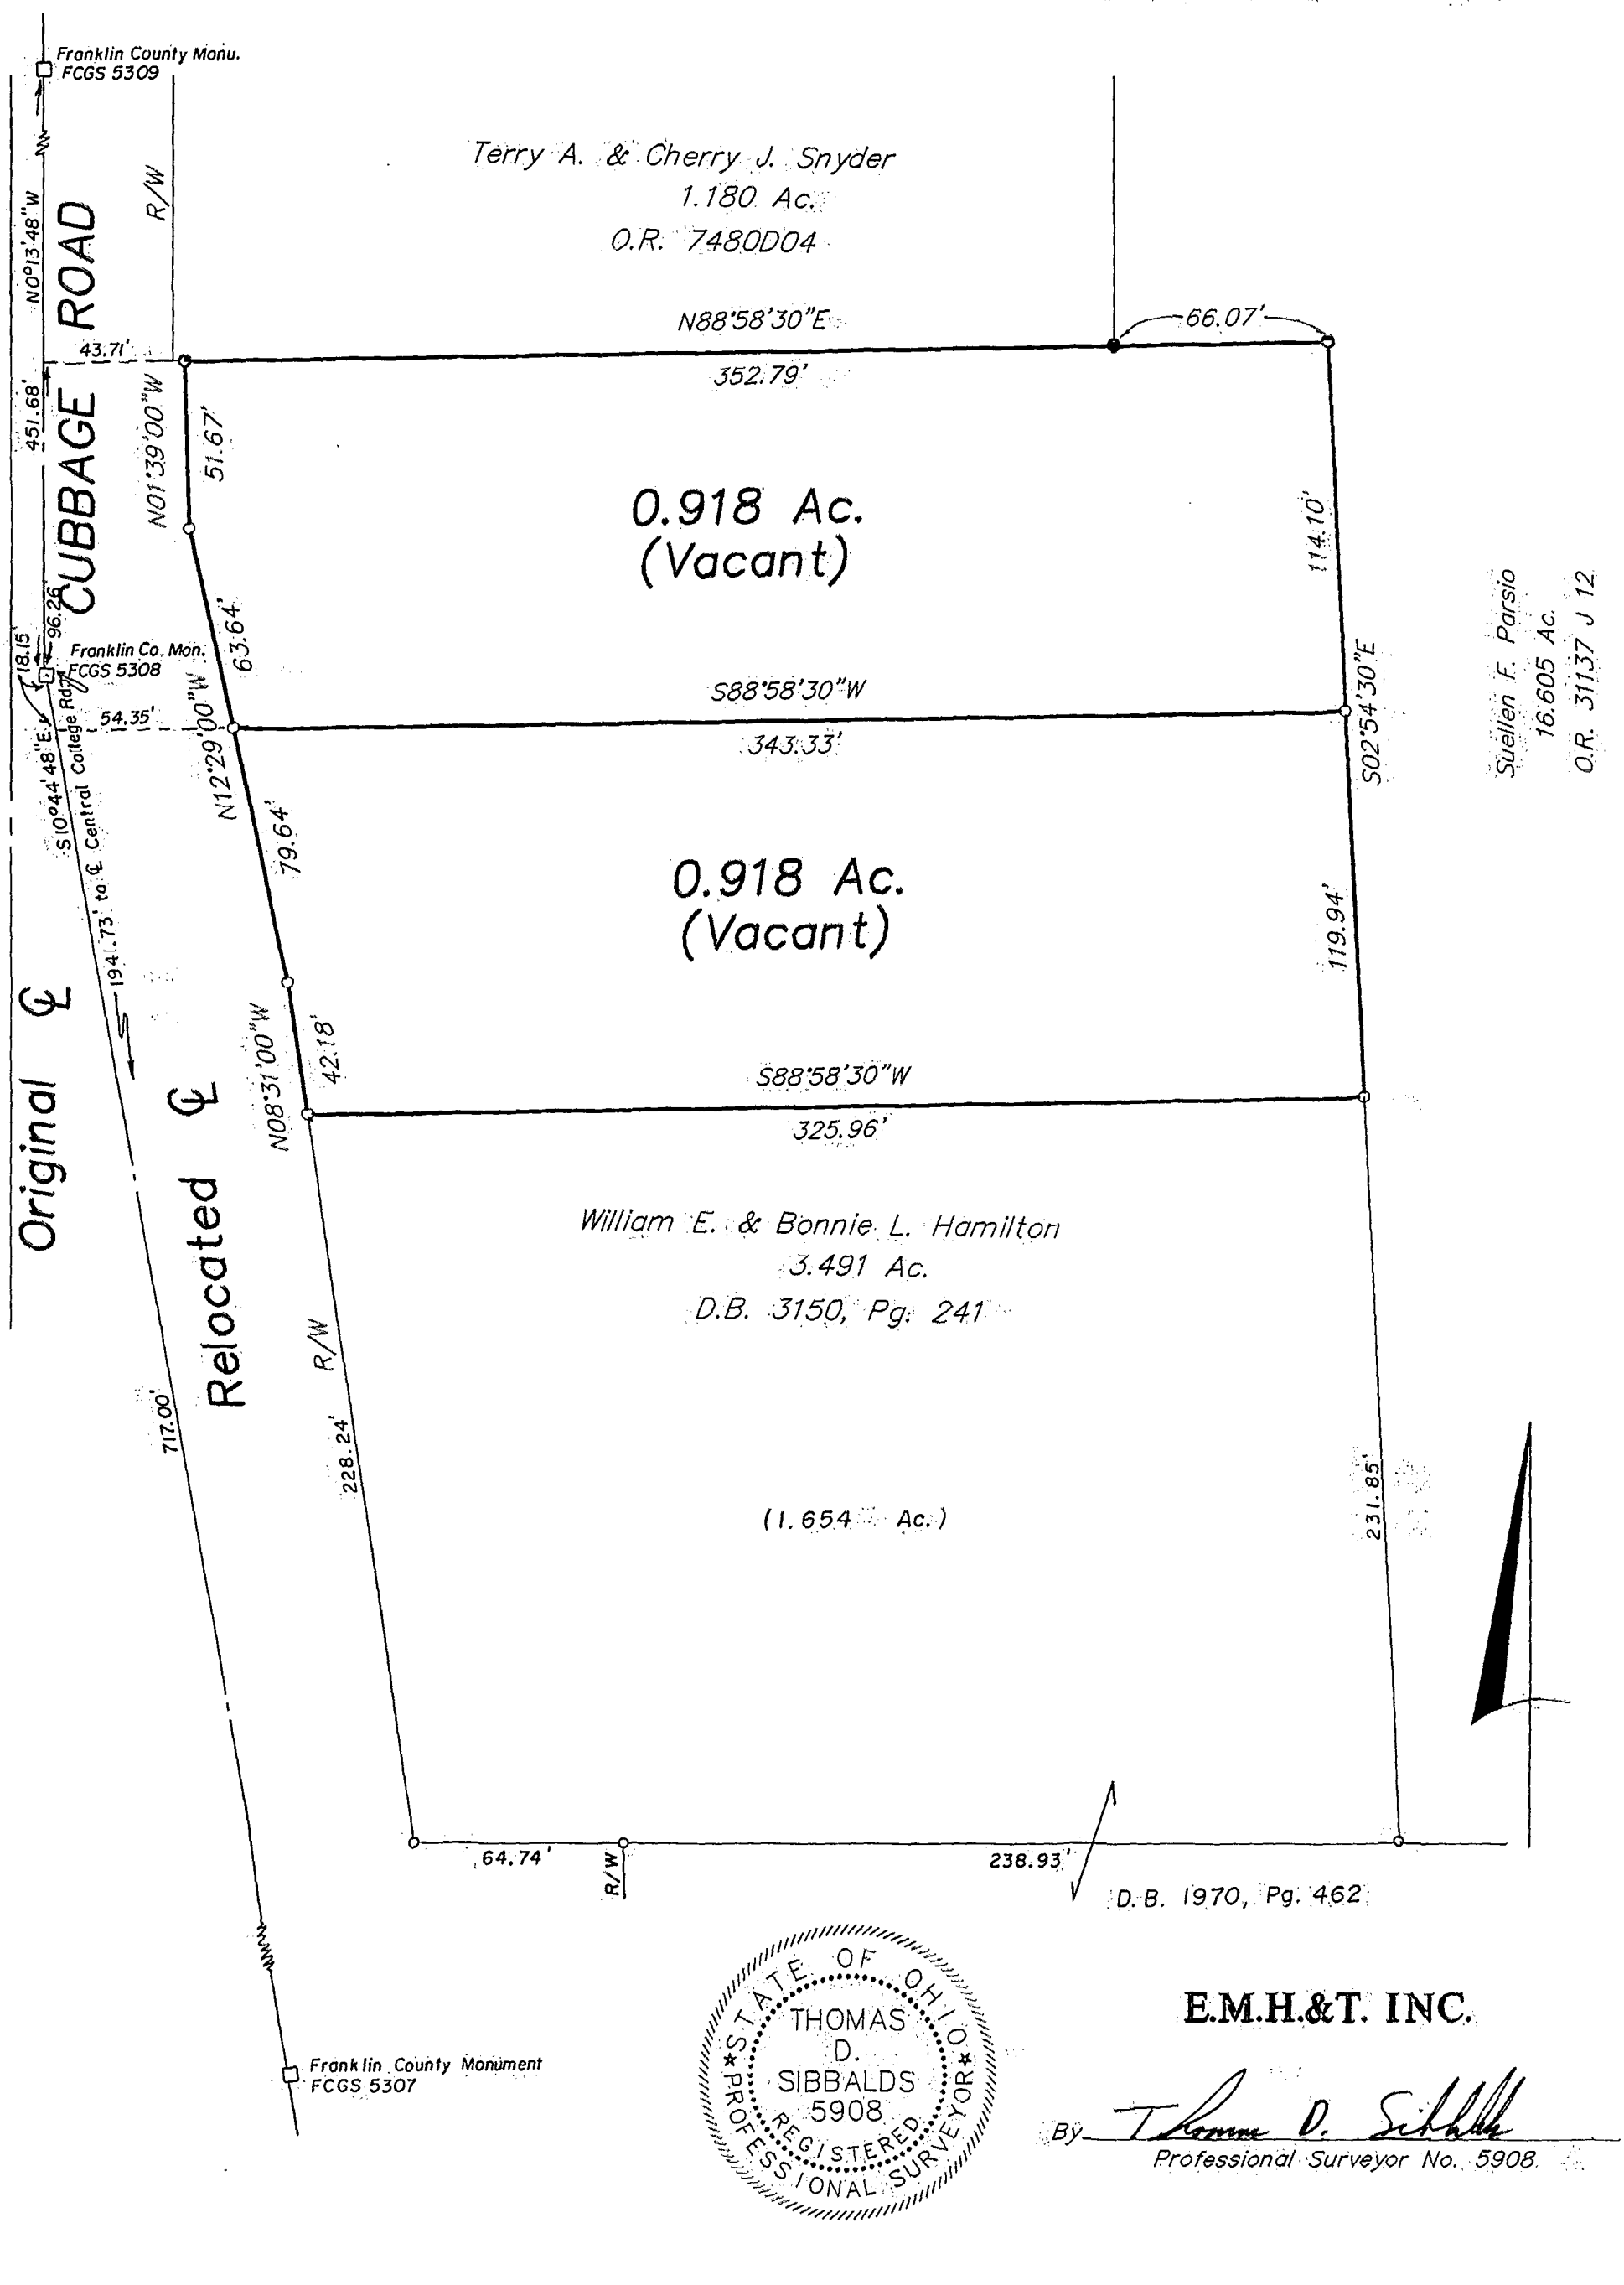

STATE OF OHIO
THOMAS D. SIBBALDS
5908
REGISTERED PROFESSIONAL SURVEYOR

E.M.H.&T. INC.

By Thomas D. Sibbalds
Professional Surveyor No. 5908