18660 7675
18685 7675

0-73-D

SURVEY FOR
JOHAN LEONARD HELLEBRAKERS
LOCATION
PLAIN TOWNSHIP - FRANKLIN COUNTY
RANGE 16 - TOWNSHIP 2 - QTR. TWP. 2 - HALF SECTION 11

Scale 1" = 100' Date 6-21-71 P.B. ____ P. ____ D.V. 3140 P. 172 Lot No. ____

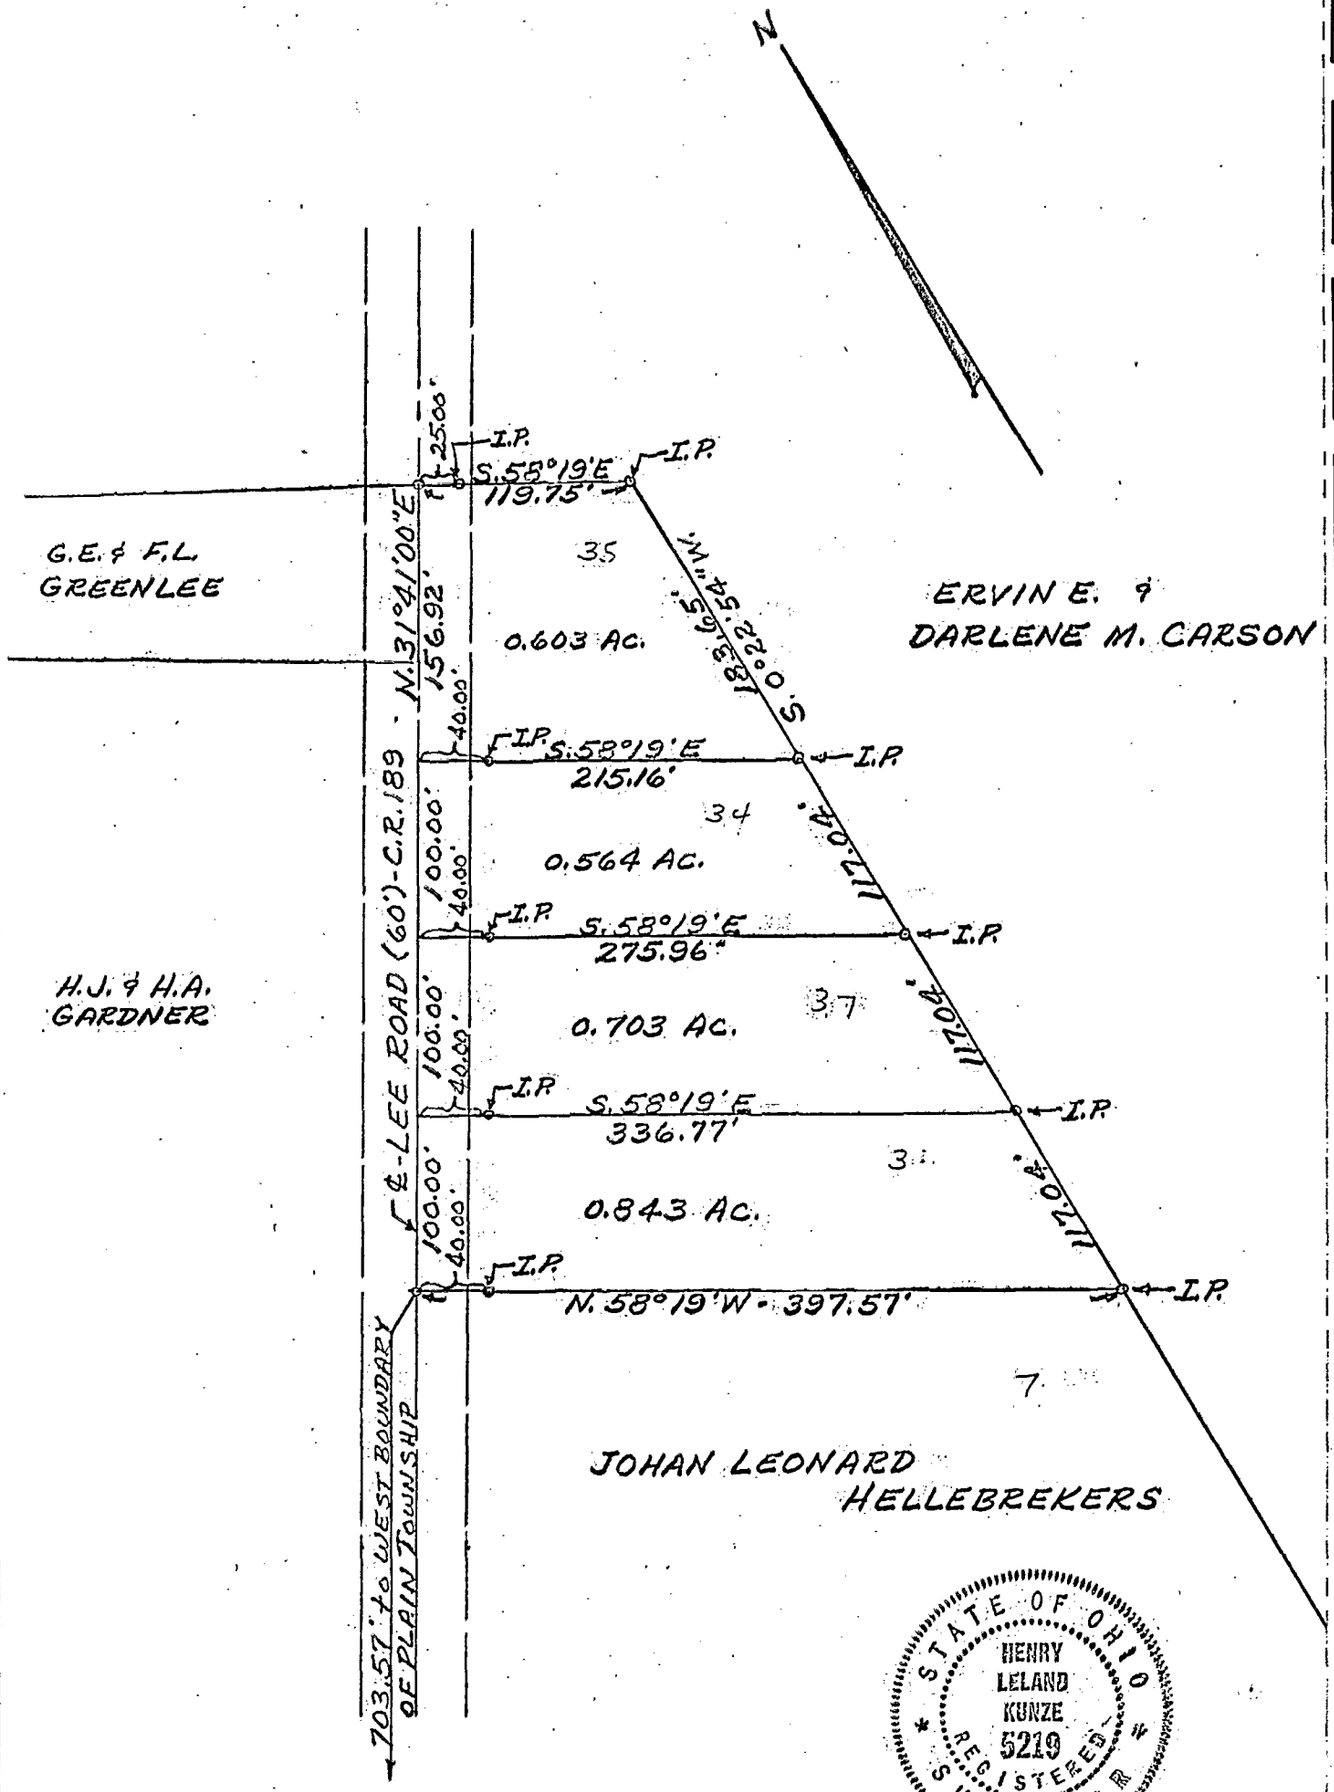

STATE OF OHIO
HENRY LELAND KUNZE
5219
REGISTERED SURVEYOR

I hereby certify that the foregoing drawing was prepared from an actual survey of the premises.

Drawn by H. L. K.

Henry L. Kunze
Registered Surveyor No. 5219

KUNZE, GAMES AND STREET, INC.
CIVIL ENGINEERS AND LAND SURVEYORS
6914 SUNBURY ROAD, WESTERVILLE, OHIO 43081