

PERRY ASSOCIATES, INC.

CONSULTING ENGINEERS AND SURVEYORS
P.O. BOX 429 THORNVILLE, OHIO 43076

OHIO PHONE: 1-800-648-8151 FAX NO. 1-800-648-8150

PROPERTY LOCATION


SITUATED IN THE STATE OF OHIO, COUNTY OF FRANKLIN, TOWNSHIP OF PLAIN AND BEING A PART OF THE EAST HALF OF THE NORTHEAST QUARTER OF SECTION 6, TWP.-2, RNG.-16 OF THE LANDS IN THE U. S. MILITARY DISDRICT.

BEING A SURVEY OF A PORTION OF THE PARCEL CONVEYED TO LOIS A. ENGLISH AS RECORDED IN IN DEED VOLUME 3042 PAGE 577 IN THE FRANKLIN COUNTY RECORDERS OFFICE.

PREPARED FOR:

**CHRISTOPHER &
DAWN CARROLL**

FILE NO. 991624FR
INVOICE NO. 9903012

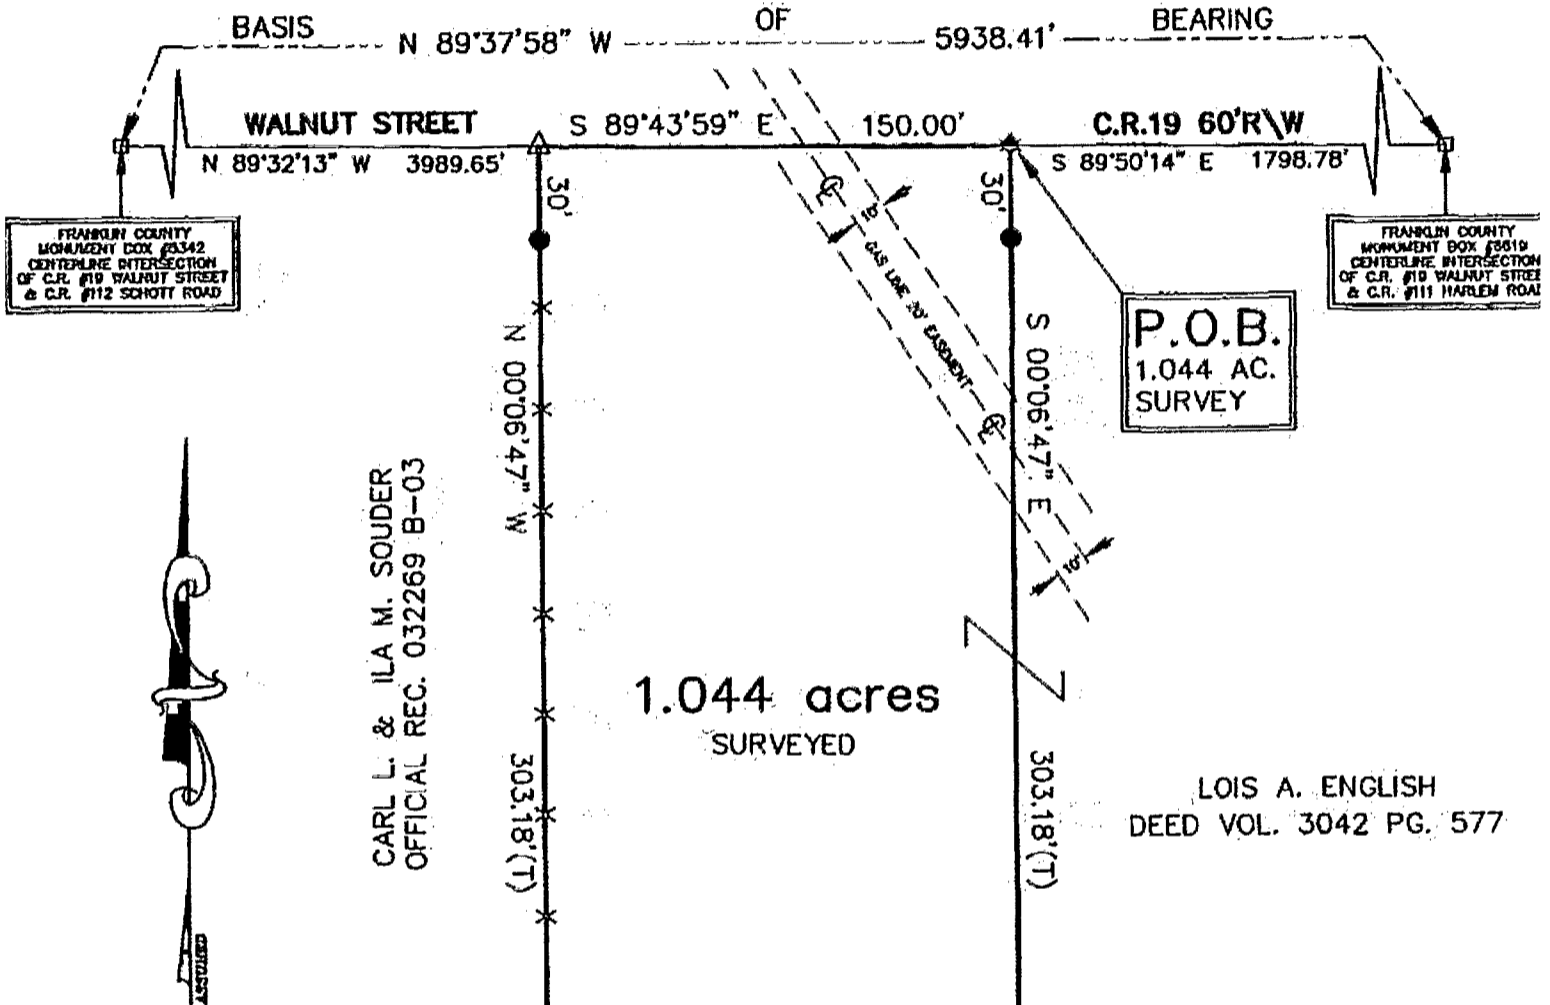

P.O.B.
1.044 AC.
SURVEY

CARL L. & ILLA M. SOUDER
OFFICIAL REC. 032269 B-03

LOIS A. ENGLISH
DEED VOL. 3042 PG. 577

LOIS A. ENGLISH
DEED VOL. 3042 PG. 577





LEGEND

- - IRON PIN FOUND
- - IRON PIN SET
- △ - RAILROAD SPIKE FOUND
- ▲ - RAILROAD SPIKE SET
- ☆ - P. K. NAIL FOUND
- ★ - P. K. NAIL SET
- (T) - TOTAL DIMENSION
- X-X - FENCED LINE
- P - PROPERTY LINE

NOTE: ALL PINS SET ARE 5/8" o.d. IRON REINFORCING BARS WITH YELLOW CAPS. LABELED "DENNIS P. HAGAN #6917".

I HEREBY CERTIFY THAT AN ACTUAL SURVEY WAS MADE OF THE PREMISES AND THAT THIS PLAT IS CORRECT TO THE BEST OF MY KNOWLEDGE.

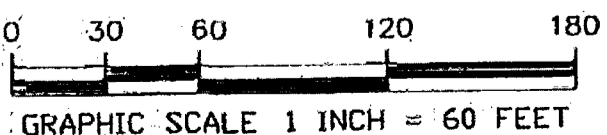

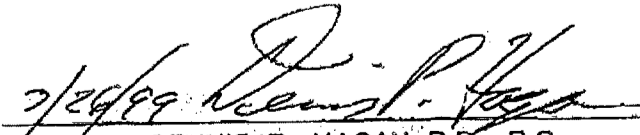DATED 2/26/99 
 DENNIS P. HAGAN P.E., P.S.
 OHIO REGISTERED SURVEYOR #691

87 107 675
87 107 2005