ETON & TILTON, INC.

ENGINEERS — SURVEYORS
GAHANNA, OHIO

SURVEY OF ACREAGE PARCELS

Located in S.E. Quarter Section 6, Township 2, Range 16
United States Military Lands
Plain Township, Franklin County, Ohio

SCALE 1" = 100'

o = Iron Pin
□ = Tacked Hub
August 23, 1965

DEED BOOK 2460, PAGE 686
PLAT BOOK ____, PAGE ____

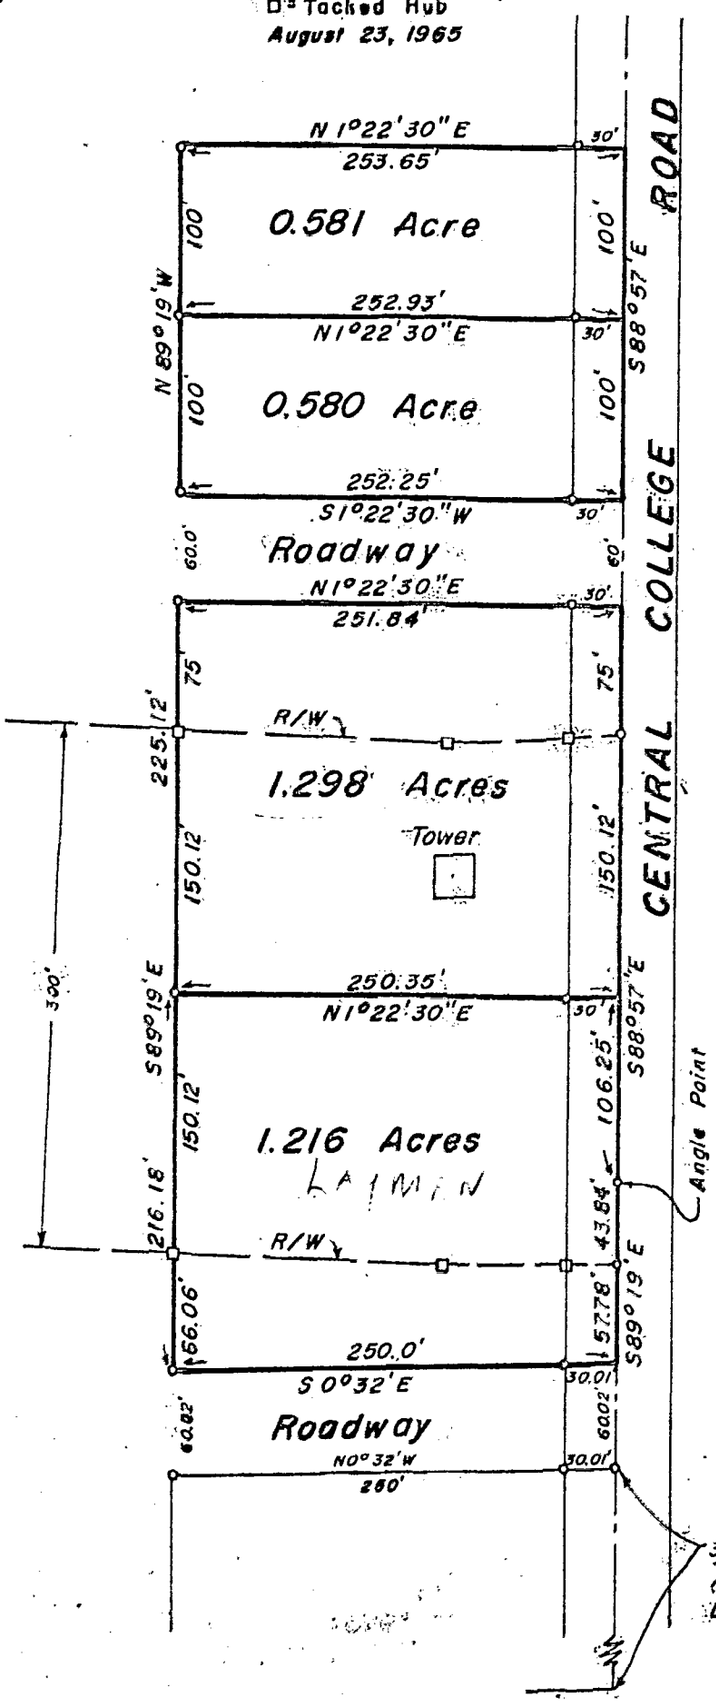

We hereby certify that the foregoing plat was prepared from an actual survey of the premises and shows the location of the boundaries

EVANS MECHWART HAMBLETON & TILTON, INC.

BY _____
Registered Surveyor # 483

1366-55-2813