HOY SURVEYING SERVICES, INC.

2654-98-S
ORDER NO.

0 CLEVELAND AVENUE COLUMBUS, OHIO 43231 PHONE 614-895-1922 FAX 614-895-194

ERTIFIED TO RONALD SCHLEPPI COUNTY OF FRANKLIN

ENDER N/A P.B. ____ PG. ____ OR. ____ PG. ____

UYER ____ DATE 8/25/98 SCALE 1"=100' DRN. SAS. CH. S.J.H.

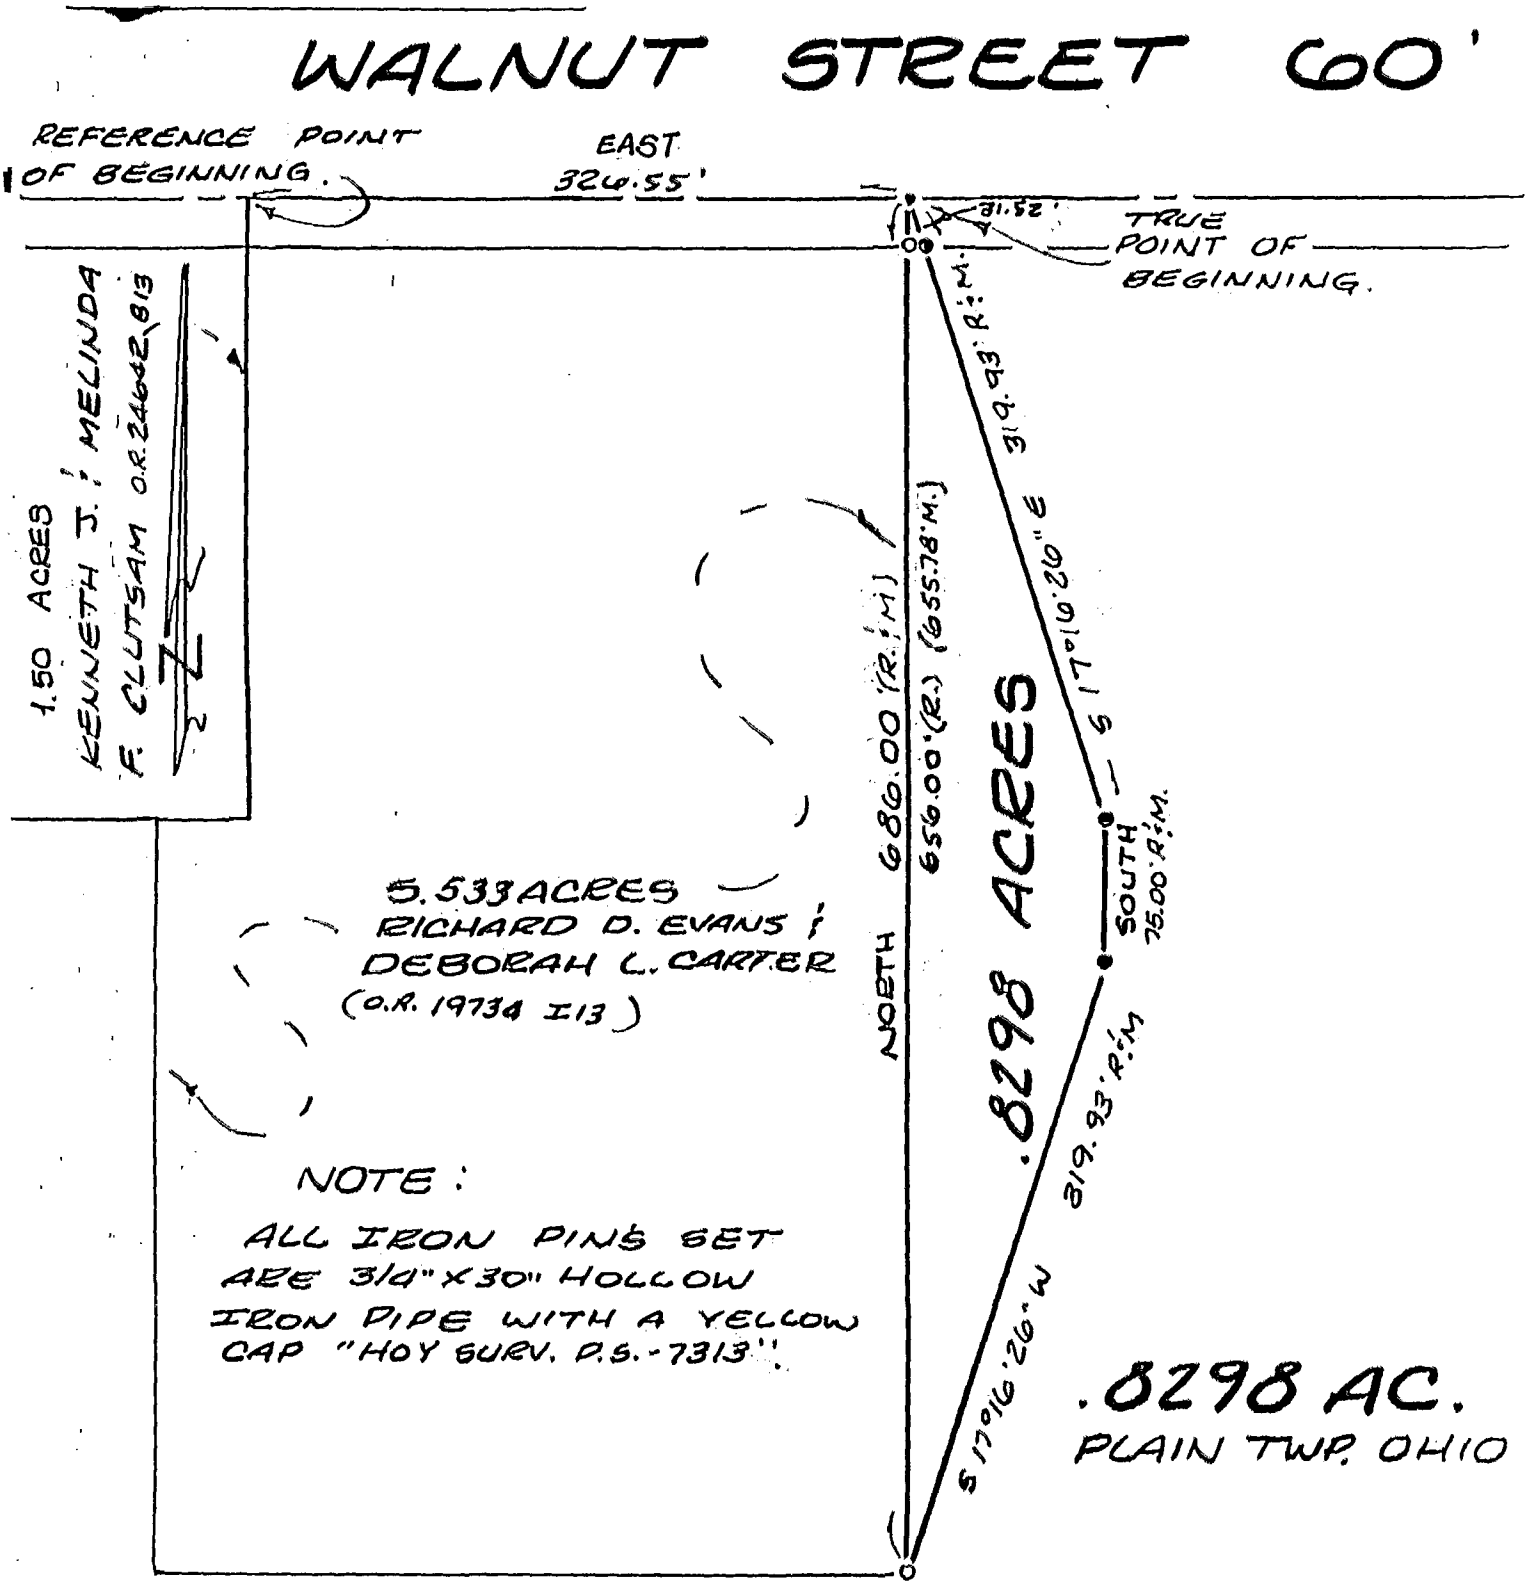

NOTE:
ALL IRON PINS SET ARE 3/4" X 30" HOLLOW IRON PIPE WITH A YELLOW CAP "HOY SURV. P.S.-7313".

● INDICATES IRON PIN SET.
o INDICATES IRON PIN FOUND.
• INDICATES PK. NAIL SET.

We hereby certify that the foregoing **BOUNDARY SURVEY** was prepared in accordance with Chapter 4733-37, Ohio Administrative Code, pursuant to Chapter 119 of the Ohio Revised Code.

By ____
Registered Surveyor No. 7313

STATE OF OHIO STEVEN J. HOY 7313 REGISTERED SURVEYOR

795 76 75

87 09 75